


T.IOS.,R.IW.,W.M.

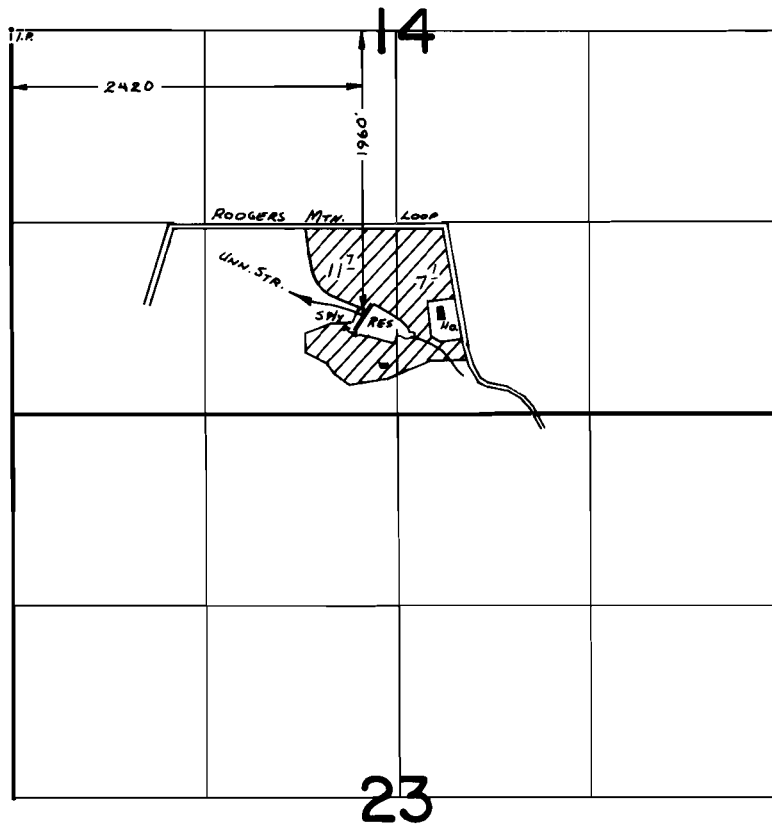

FINAL PROOF SURVEY
UNDER

R-54634 R-6500
Application No. 54635 Permit No. 40696
IN NAME OF

Andrew N. Westlund

Surveyed June 2, 1982, by L.M. TOLL