


T.IOS.,R.IW.,W.M.

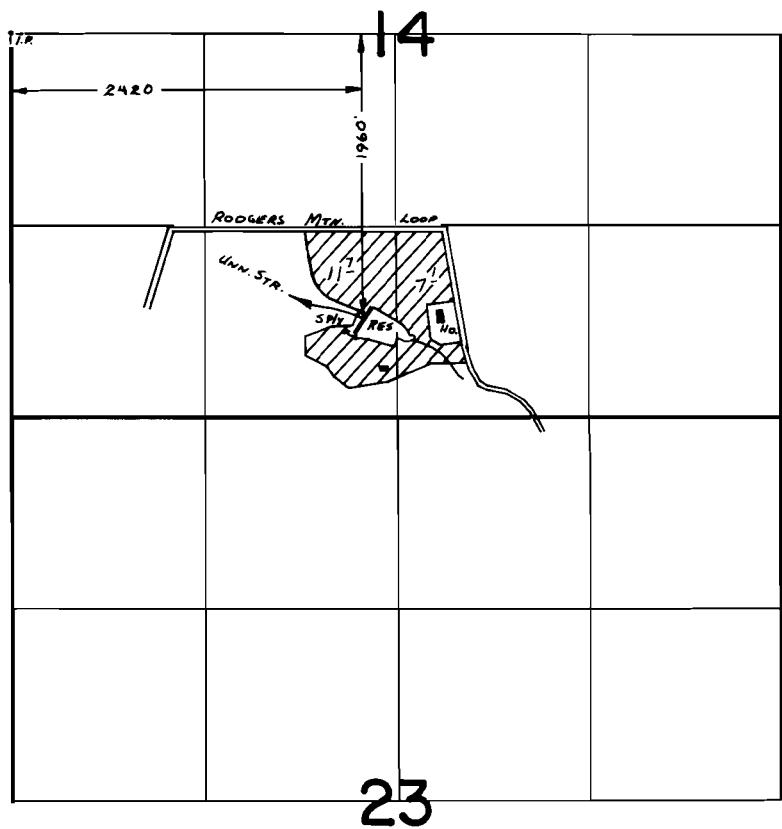

**FINAL PROOF SURVEY**  
UNDER

R-54634 R-6500  
Application No. 54635 Permit No. 40696...  
IN NAME OF

.....Andrew N. Westlund.....

Surveyed June 2, 1982, by L.M. TOLL.....