


# T.I.S., R.I.E., W.M.

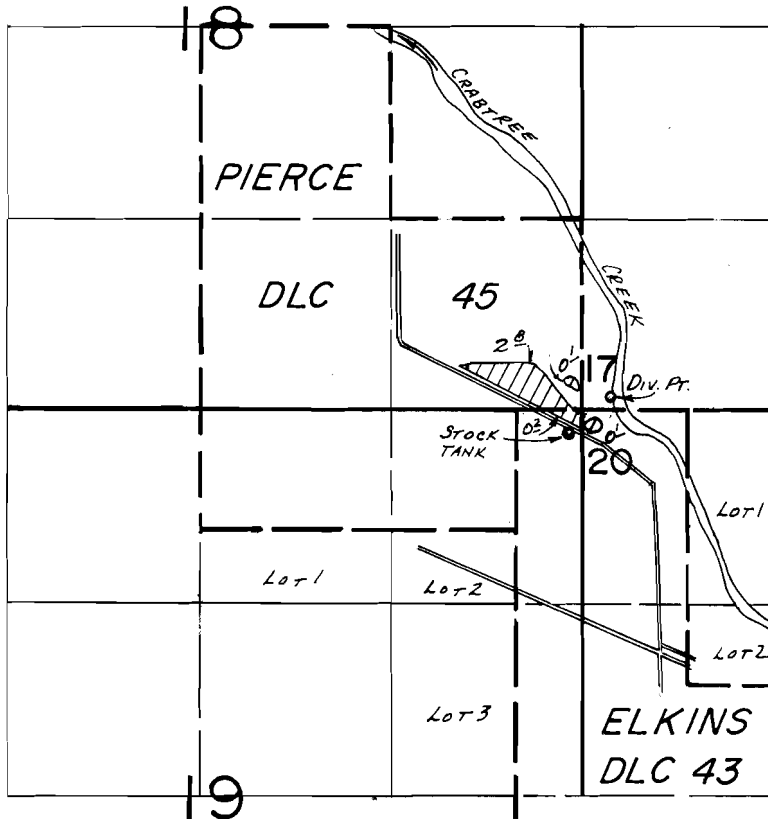

Div. Pt. Loc.: 90° N. & 200' E. FROM SW COR. SEC. 17.

SCALE: 1" = 1320'

## FINAL PROOF SURVEY UNDER

Application No. ~~61654~~... Permit No. ~~45741~~.....

IN NAME OF

.....SHIRLEY & OMER BADGER.....

Surveyed Sept. 6... 1985, by T.M. WARREN....