


T.1S., R.2W., W.M.

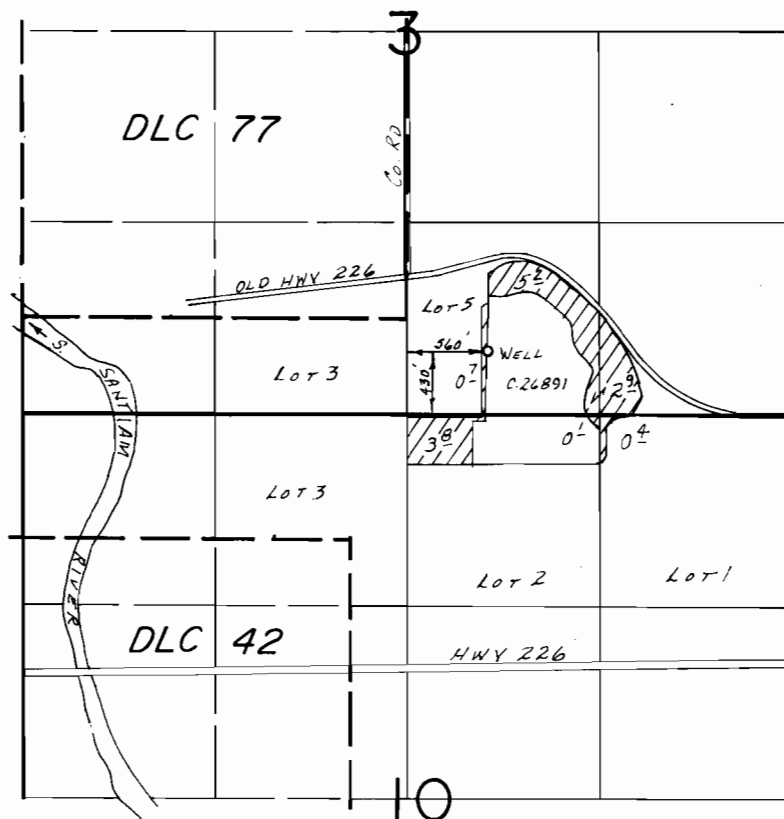

SCALE: 1"=1320'

FINAL PROOF SURVEY UNDER

Application No. ~~G:6679~~ Permit No. ~~G:6231~~.....
IN NAME OF

.....RALPH L. BENDER.....

Surveyed Sept. 5... 19.85, by T.M. WARREN.....