


T8S R2W WM

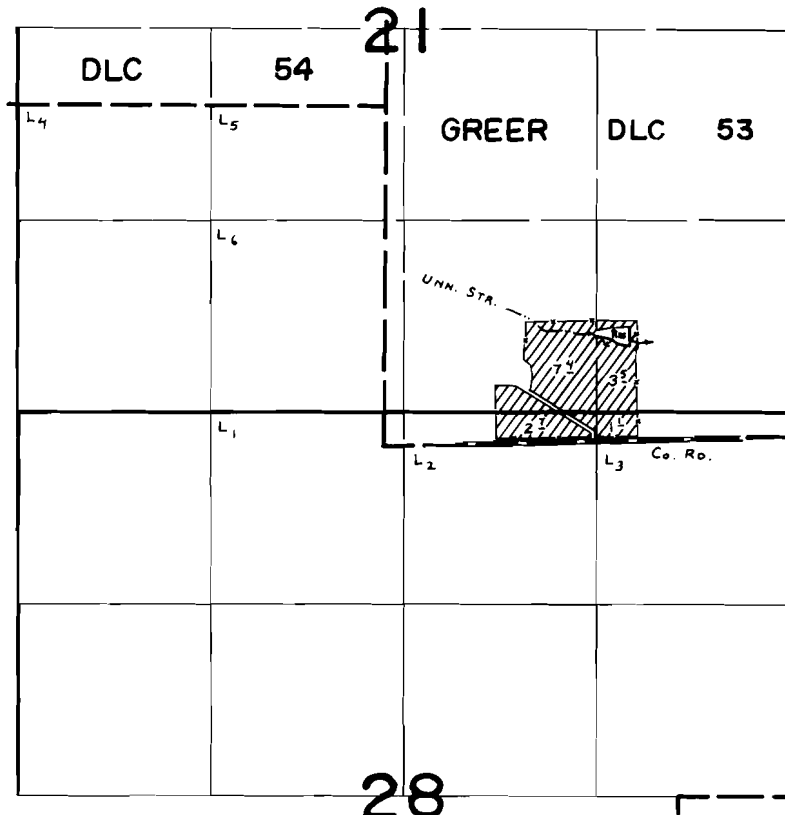

Res. Loc: 750' N. & 1550' E. fr. S.W. Cor. D.L.C. 53.

FINAL PROOF SURVEY UNDER

R-53831 R-6447
 Application No. 54110 Permit No. 40508
 IN NAME OF

CONRAD C. BOOZE

Surveyed APR. 22, 1980, by C. L. HUGHES