# T9S RIE WM

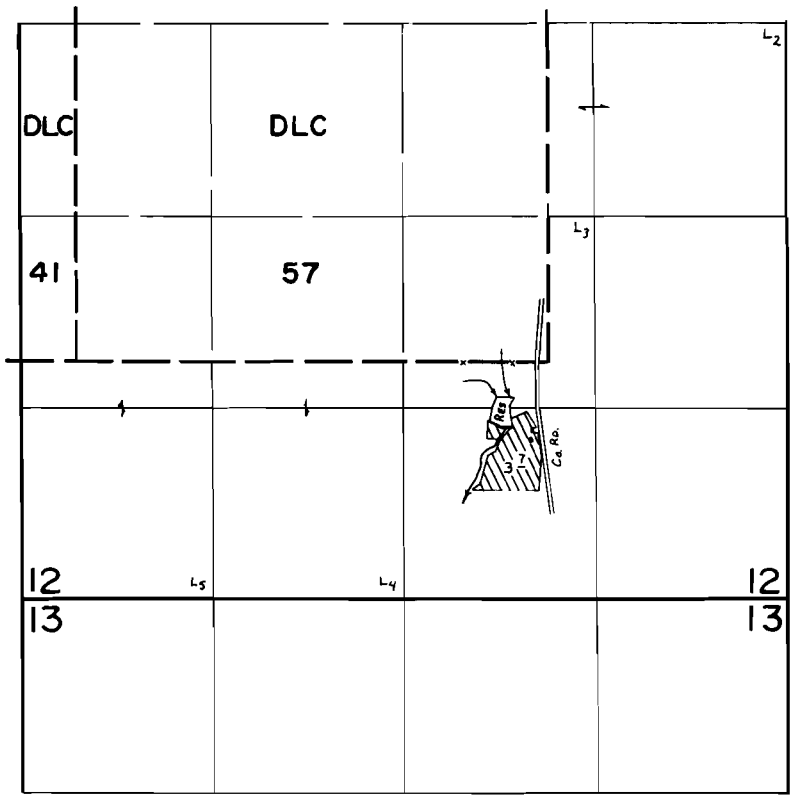


DAM LOC: 450'S. & 300'W. fr. S.E. COR. FITZGERALD D.L.C. 57.

## FINAL PROOF SURVEY

UNDER

Application No. R-53854 54027 Permit No. R-6448 40477

IN NAME OF

MELVIN L. HALL

Surveyed APR. 25 19.80, by C. L. HUGHES

PTS-1980-J