


# T9S R2E WM

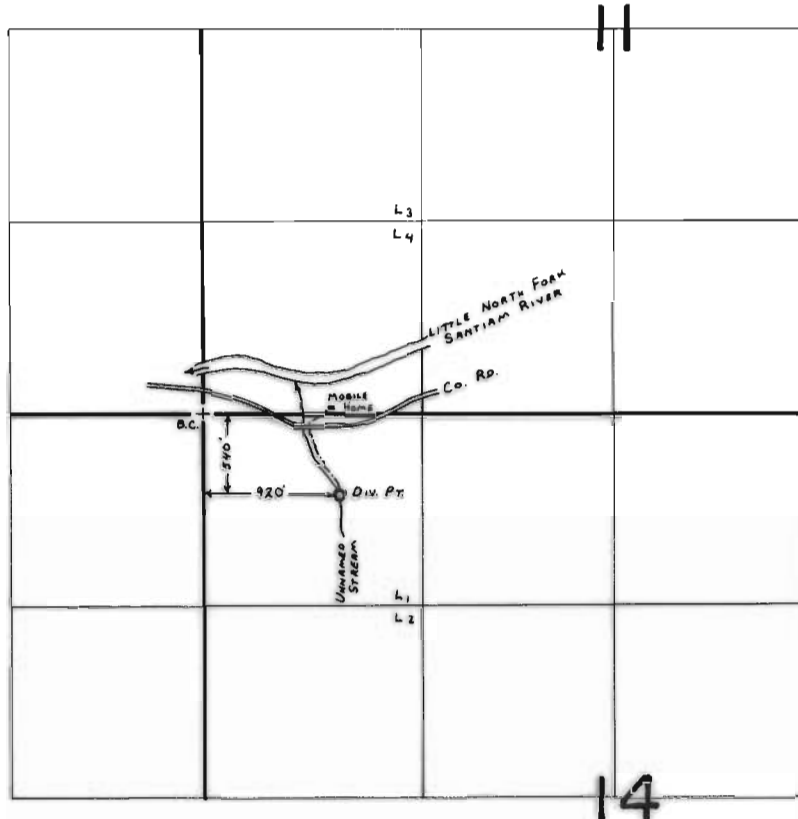

## FINAL PROOF SURVEY UNDER

Application No. 50920 Permit No. 38445  
IN NAME OF

WILLIAM D. MITCHELL

Surveyed APR 29 1980, by C. L. HUGHES