


T. 3N., R. 28E., W. M.

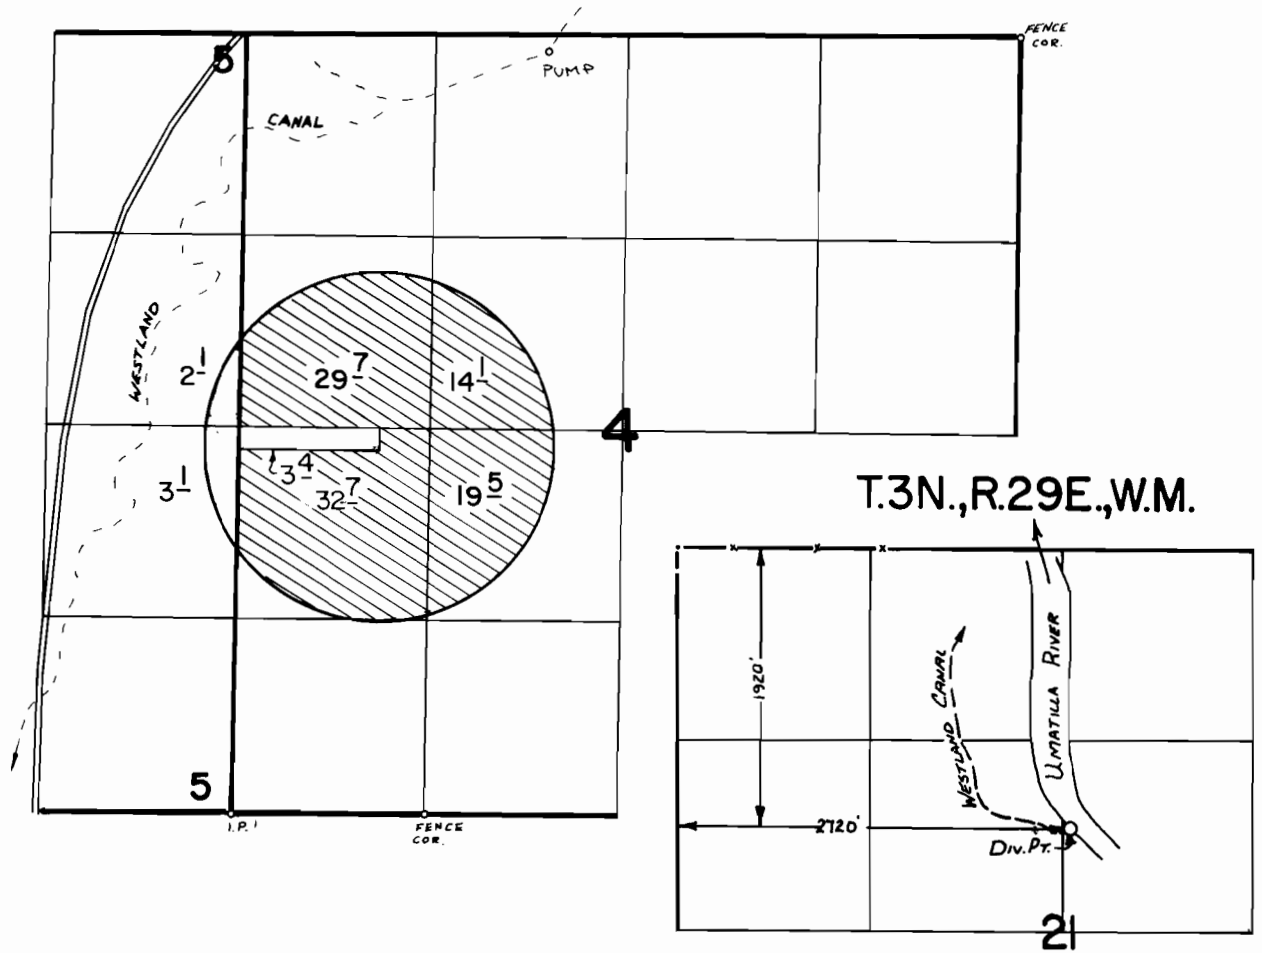

FINAL PROOF SURVEY
UNDER

Application No. 53961 Permit No. 40707
IN NAME OF
J. R. SIMPLOT CO.

Surveyed 4-30 1979, by F. BARWIN

PTS 1969-U
PTS-1979-P-A
FL 3-11

REVISED 5/10/01
LMT