


T.2S. R.44E. W.M.

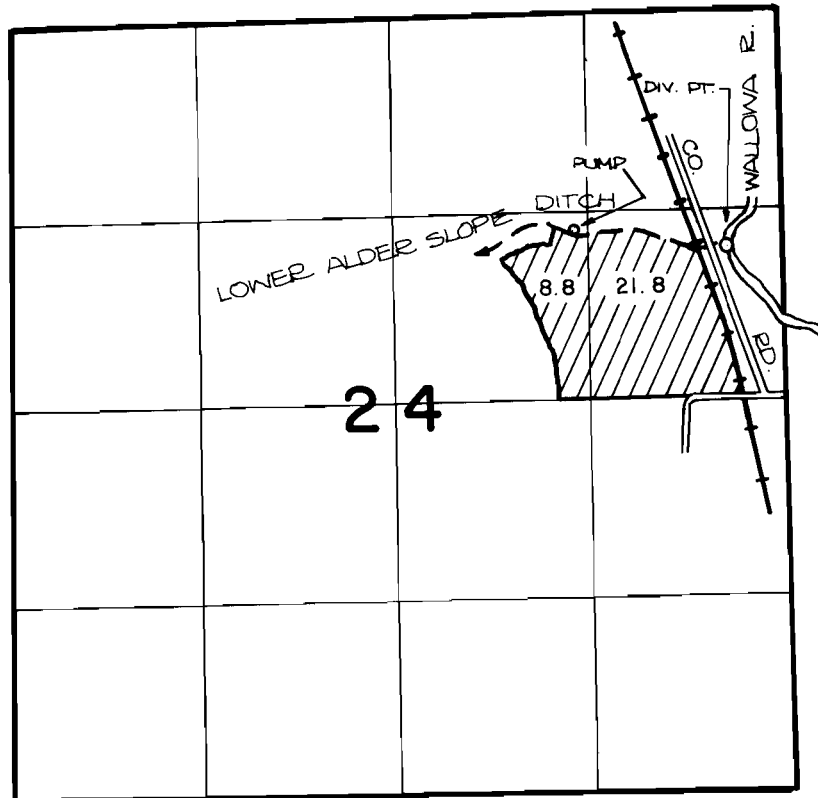

DIVERSION POINT IS LOCATED 1050' N. AND 350' W.
FROM THE E. 1/4 CORNER OF SECTION 32.

FINAL PROOF SURVEY UNDER

Application No. 539.33... Permit No. 404.02.....
IN NAME OF

.....*Michael H. and Annette Lathrop*.....

Surveyed AUG. 10... 19.82, by V...CHURCH.....