


T.2N.R.5W.W.M.

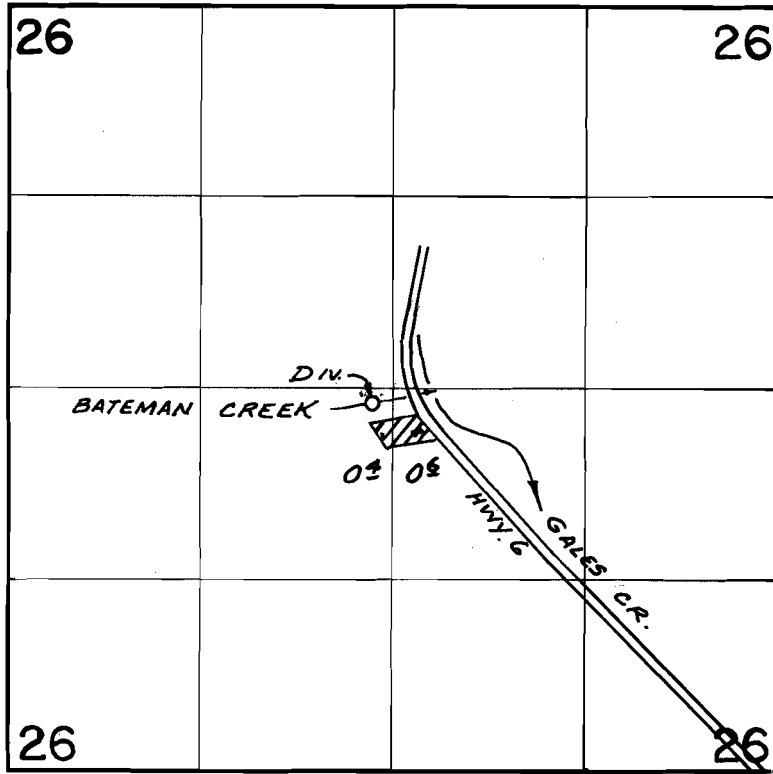

DIV. LOC: 2530' N. & 2780' W. FROM S.E. COR. SEC. 26

FINAL PROOF SURVEY
UNDER

Application No. 53436 Permit No. 39761
IN NAME OF

JOHN D. & OLIVIA J. GOBER

Surveyed NOV. 9, 1979, by R. MUCKEN