

RECEIVED

MAR 28 1975

STATE ENGINEER  
SALEM, OREGON

16 15

21 22

17 16

20 21

MILLER

B.L.M. — O. & C.

DILLON

B.L.M. — O. & C.

COX

SET 5/8" I. ROD AT  
POINT OF DIVERSION  
(SPRING)

1946.82'  
EAST

1705.55'  
NORTH

SEC. COR.  
BRASS CAP  
& 4 B.T.'S.

20 21

29 28

Application No. 52903  
Permit No. 39950


21 22

28 27

WATER LINE TRAVERSE

TRAVERSE NO.	BEARING.	DISTANCE
(HOUSE) 31	N 47° 39' 12" W	57.75'
32	N 59° 01' 00" W	133.54'
33	N 37° 16' 48" W	73.83'
34	N 33° 43' 36" W	154.41'
35		

TRAVERSE NO.	BEARING	DISTANCE
35	N 57° 49' 42" W	109.81'
36	N 46° 17' 30" W	73.66'
37	N 53° 02' 36" W	128.82'
38	N 53° 02' 36" W	52.83'
PT. OF DIV.		

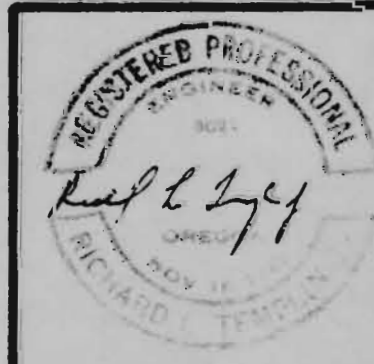

RICHARD L. TEMPLIN  
CONSULTING ENGINEER

PLAT OF SURVEY  
SURFACE WATER APPLICATION

LOCATED IN  
SW 1/4 OF SECTION 21, T.33S., R.5W., W.M.  
JOSEPHINE COUNTY, OREGON

Surveyed for: Mr. Jack Vaughn  
Scale: 1" = 400'

Nov. 22, 1974.