



# T.11S.,R.6W.,W.M.

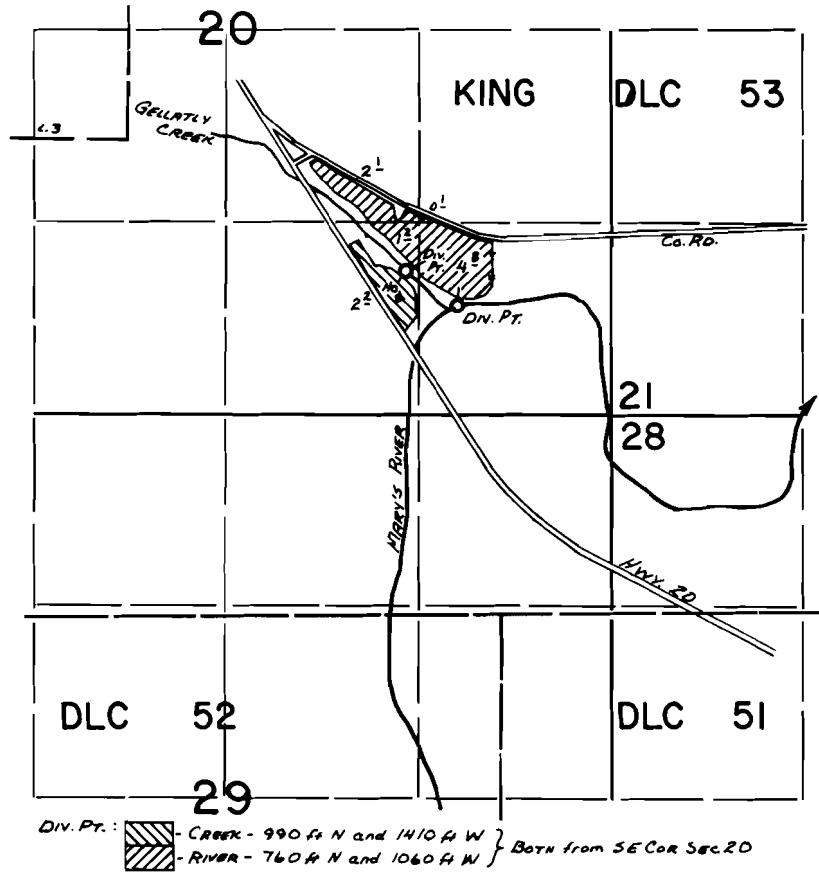

Div. Pt.:  - Creek - 990 ft N and 1410 ft W } Both from SE Cor Sec. 20  
 - River - 760 ft N and 1060 ft W }

## FINAL PROOF SURVEY UNDER

Application No. 54697... Permit No. 41036.....  
 IN NAME OF

QUITMAN E. & VEDA N. MCKEE

Surveyed Sept. 10, 1982, by L.M. TOLL.....