


2



UNDER

IN NAME OF

DAVID RANDOLPH MORRIS

Surveyed Oct. 2 1979, by C. L. HUGHES