


T.3S. R.5E. W.M.

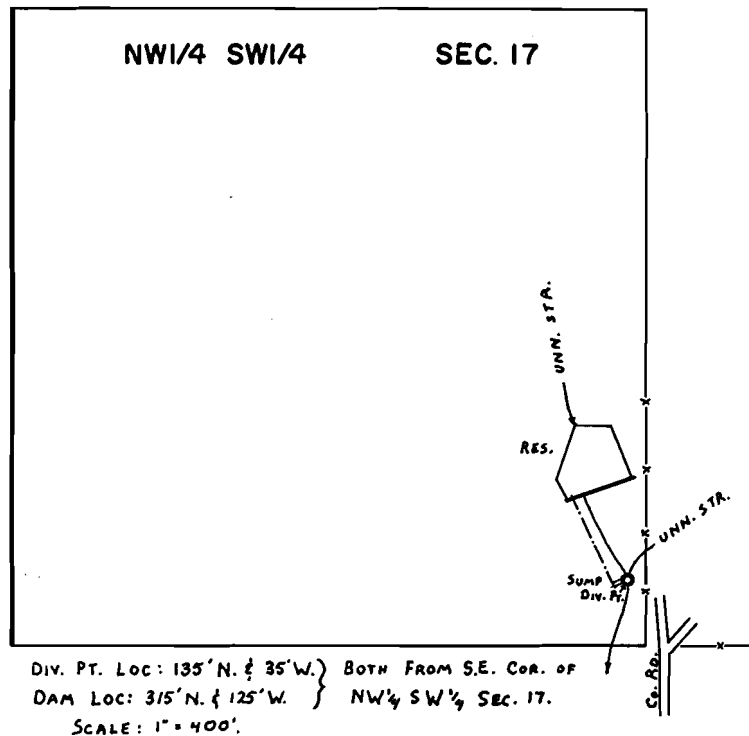

FINAL PROOF SURVEY
UNDER

R-54235 R-6476
54236 40590
Application No. ~~56424~~ Permit No. ~~42101~~.....
IN NAME OF

.....**BRUCE W. MCCULLOUGH**.....

Surveyed July 10, 1978, by C. L. HUGHES.....
April 26 1979