


T. 3S., R. 4E., W.M.

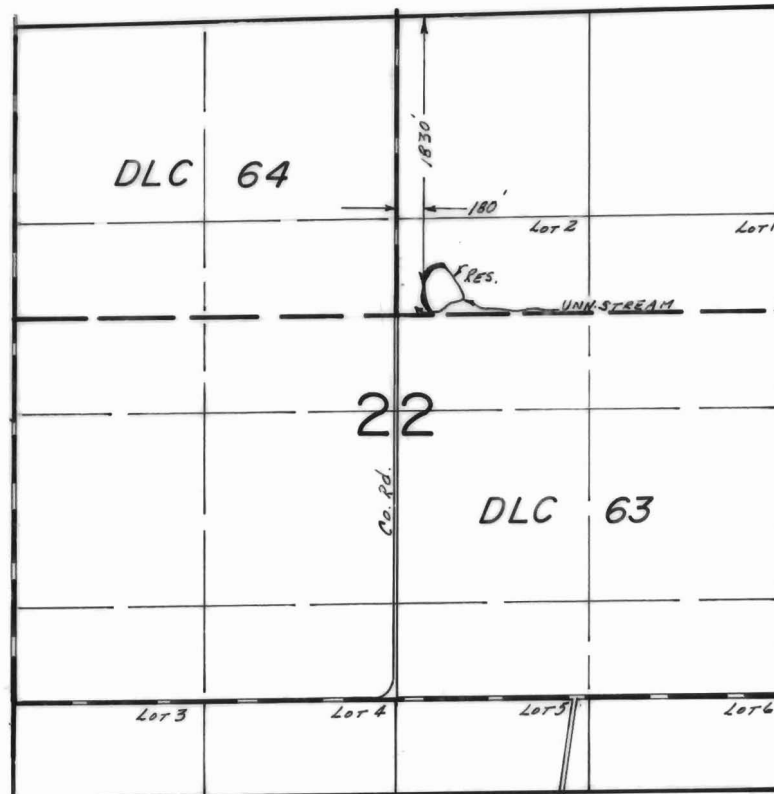

SCALE: 1"=1320'

FINAL PROOF SURVEY
UNDER

R-57568 R-7513
Application No. 57569... Permit No. 43200.....
IN NAME OF

.....JACK SKIPPER.....

Surveyed Aug. 7..... 1984, by R.W. BISHOP.....