


T.3S. R.1E. W.M.

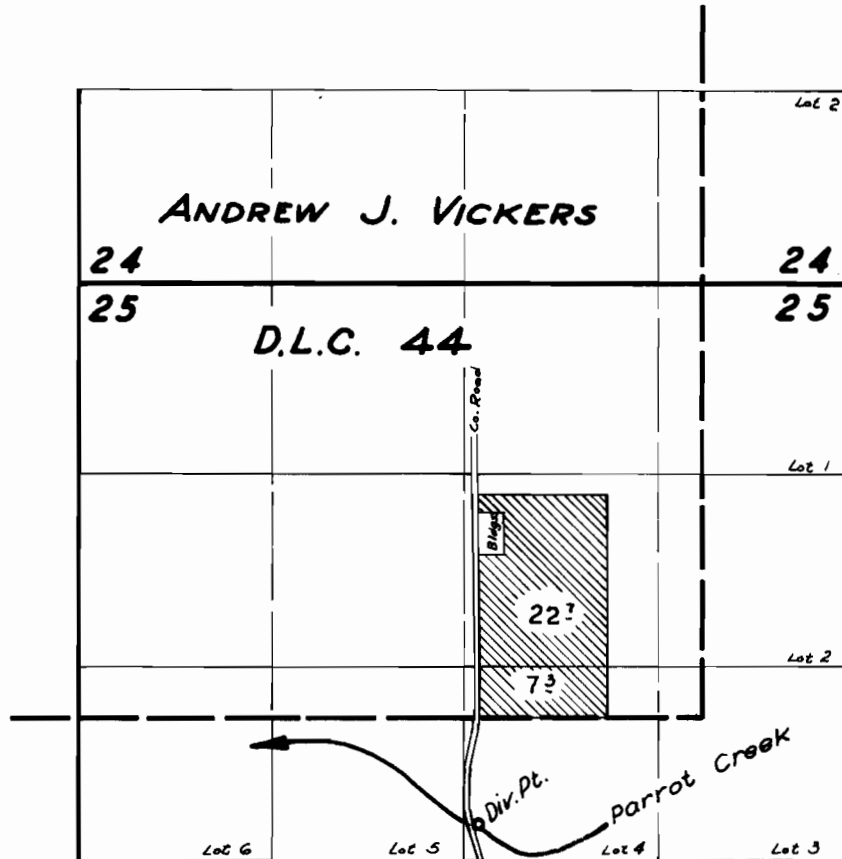

**FINAL PROOF SURVEY**  
UNDER

Application No. 30227... Permit No. 23829  
IN NAME OF

**GORDON L. SCHOONOVER**

Surveyed 7 Oct. 1958, by C. O. Bartels