


T.2S.R.IE.W.M.

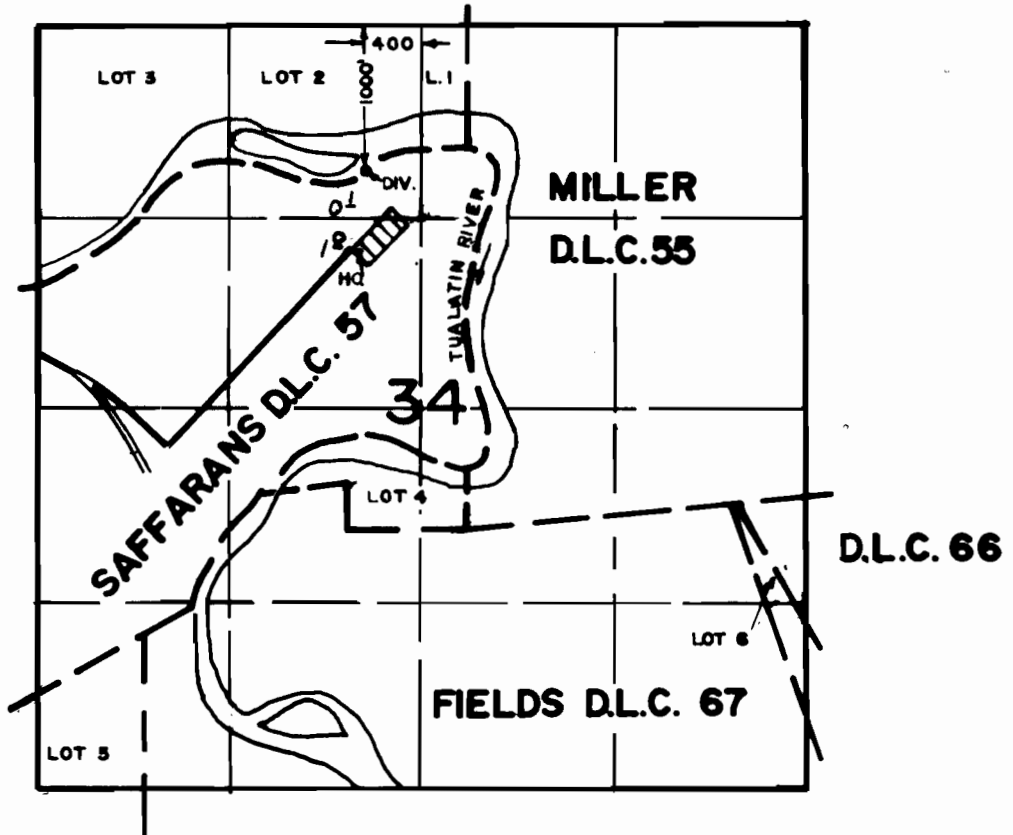

FINAL PROOF SURVEY UNDER

Application No. 53531... Permit No. 40067.....
IN NAME OF

.....ALFONSO UMBRAS.....

Surveyed MAR.11..... 1980., by .R.G.MUCKEN.....