


T.2S.R.3E.W.M.

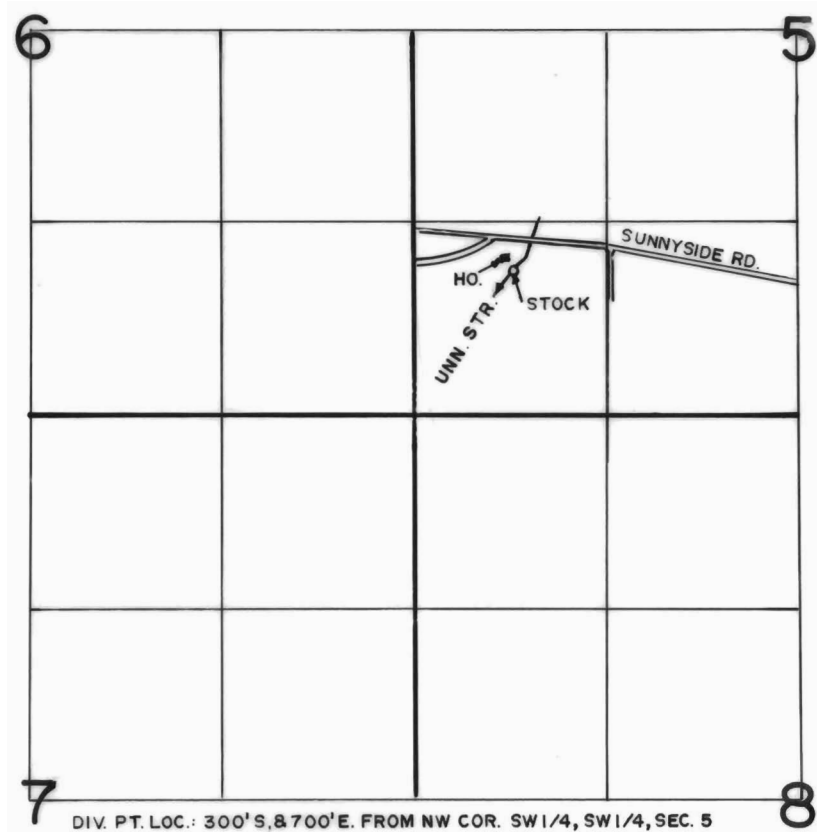

FINAL PROOF SURVEY UNDER

Application No. 58017... Permit No. 43708.....
IN NAME OF

.....MYRL N. & MARILYN A. FRIEND.....

Surveyed MAR..19... 19.80, by ..R.G. MUCKEN.....