


T.2S.,R.6E.,W.M.

SECTION 24

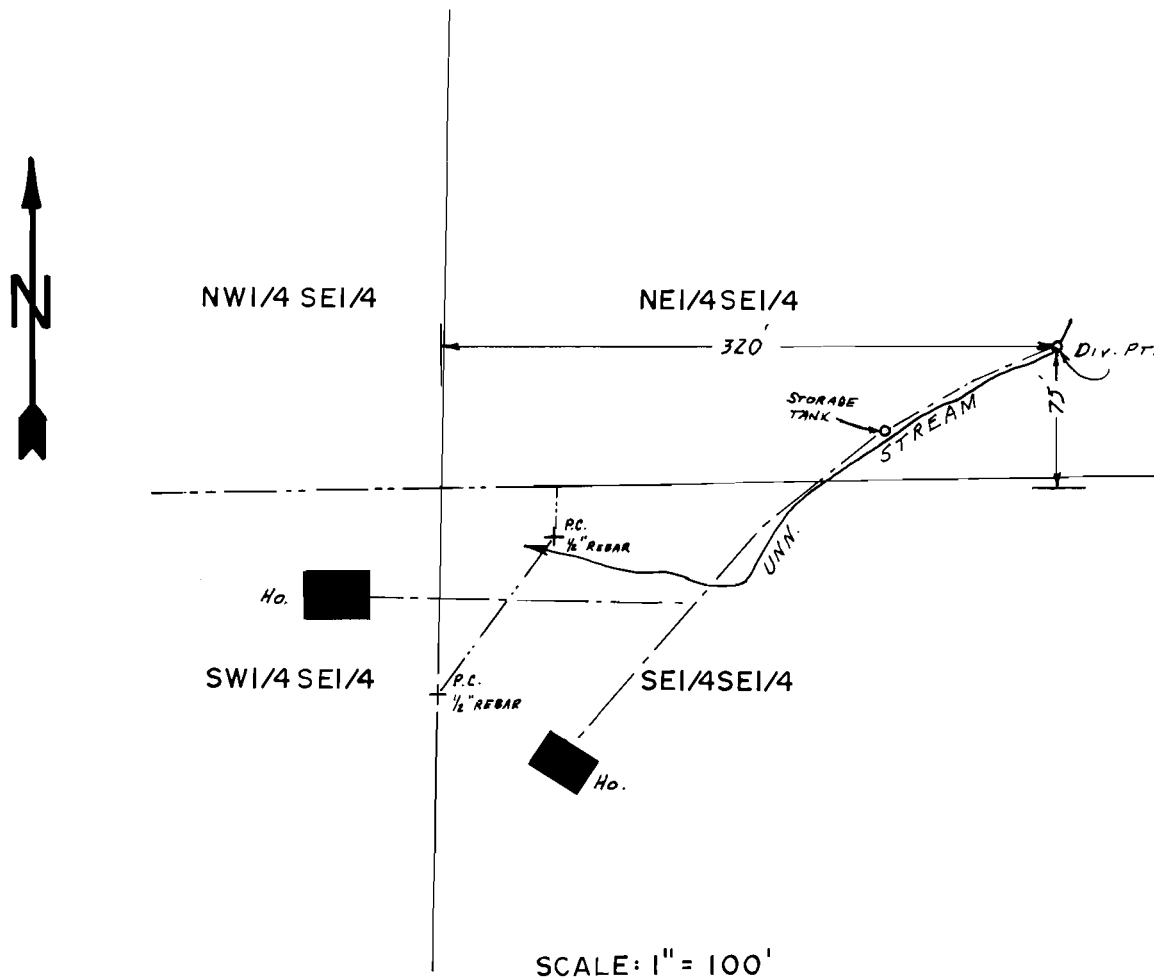

FINAL PROOF SURVEY UNDER

Application No. 61827... Permit No. 46476.....
IN NAME OF

MRS. DOROTHY M. BROWN HEIMBEAUGH

Surveyed Sept. 19... 1984, by B.W. BISHOP.....