


T.1S.R.3&4E.W.M.

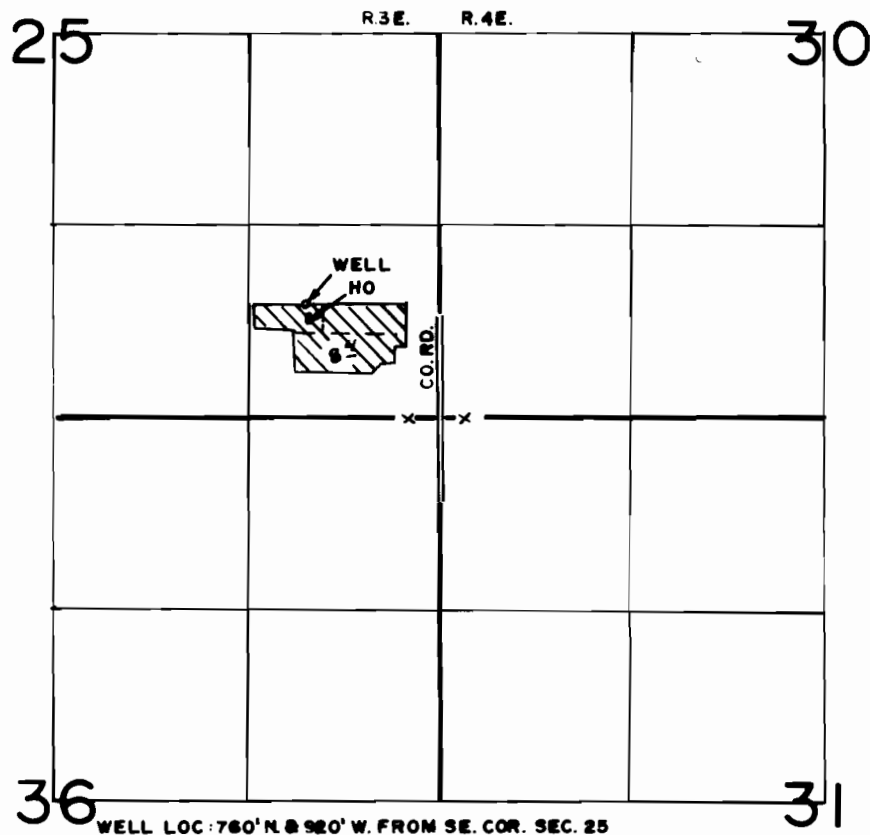

FINAL PROOF SURVEY
UNDER

Application No. G-682 Permit No. G-5859.....
IN NAME OF

ROBERT THOMPSON.....

Surveyed APRIL 2, 1980, by R.G. MUCKEN.....