


T. 3S., R. 1E., W. M.

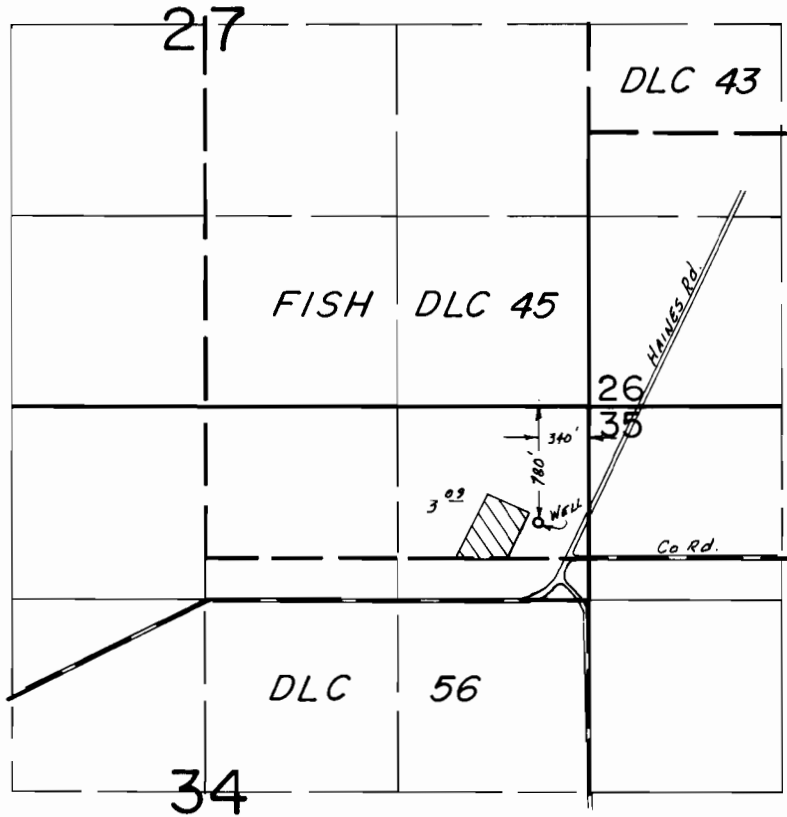

SCALE: 1" = 1320'

FINAL PROOF SURVEY
UNDER

Application No. G:9503. Permit No. G:9554.....
IN NAME OF

.....DAVID G. ADAMS.....

Surveyed AUG. 15... 19.84, by B.W. BISHOP.....