


T.37S., R.4W., W.M.

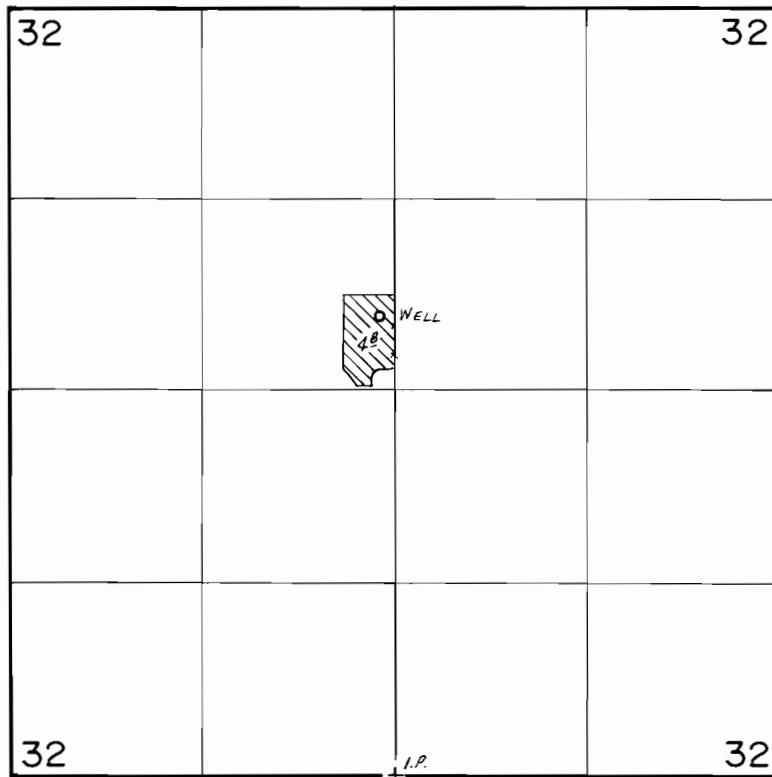

WELL LOC.: 3150' N. & 100' W. FROM S 1/4 COR. SEC. 32.

SCALE: 1" = 1320'

### FINAL PROOF SURVEY

UNDER

Application No. G.:9434 Permit No. G.:8935.....  
IN NAME OF

.....SUSAN L. BRUNNER.....

Surveyed Oct. 8..... 19.85., by B.S. JAMES.....