


T. 18 S., R. 2 W., W.M.

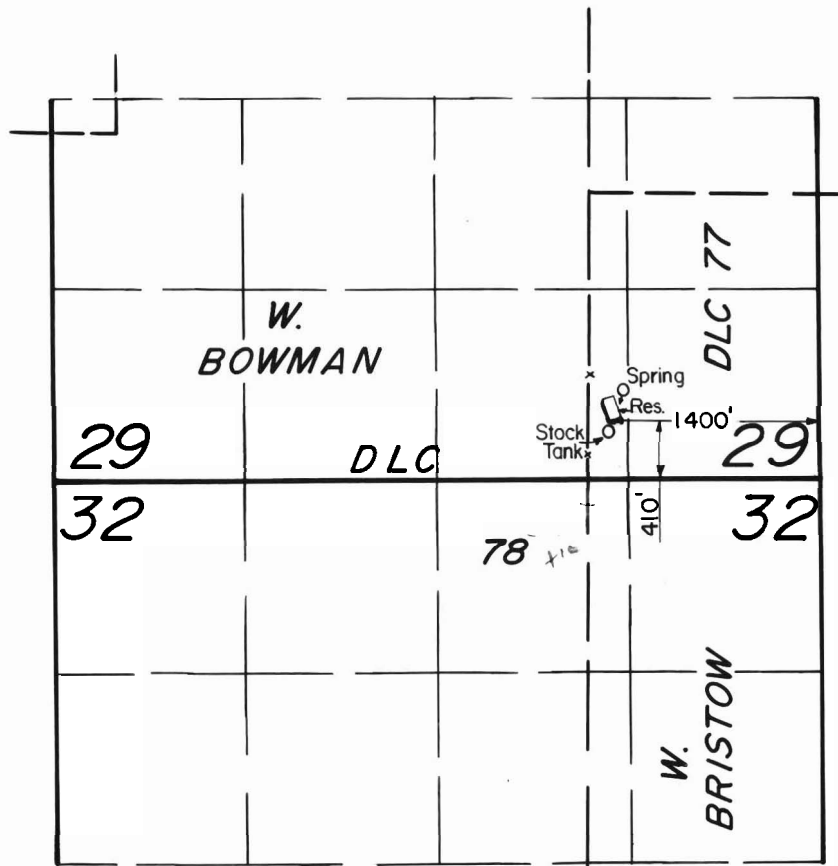

SPRING LOCATED: 630' N. & 1350' W. from the SE corner Section 29

Scale : 1" = 1320'

FINAL PROOF SURVEY UNDER

R-60537

R-8183

Application No. 60388 Permit No. 45194

IN NAME OF

VERNON L. & MARGARET A. IVERSON

Surveyed May 9 1985, by T. Warren

DBQ-2JJ-227
PTS-1985-A
TMW