


T.11S., R.2W., W.M.

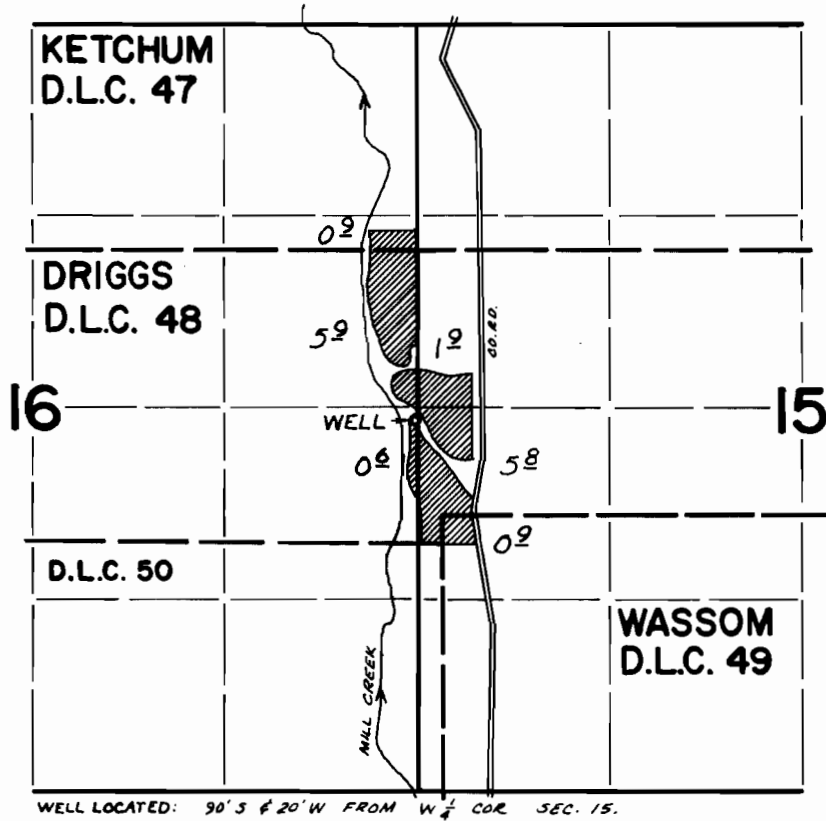

WELL LOCATED: 90' S & 20' W FROM W 1/4 COR. SEC. 15.

FINAL PROOF SURVEY UNDER

Application No. G-4752 Permit No. G-4470
IN NAME OF

ORVILLE C. & RUBY Z. VOGT

Surveyed June 18, 1973, by D. Norby