T.9S., R.3W., W.M.

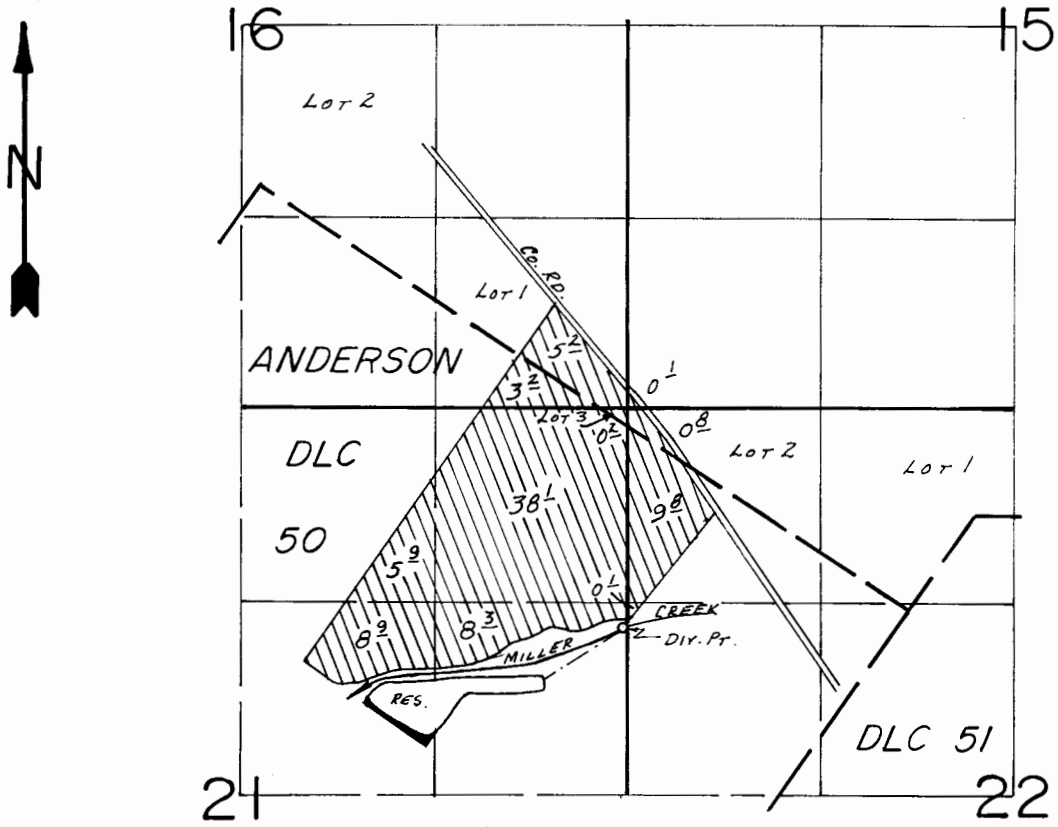

Div. Pt. Loc.: 110'S. & 1930'W. FROM E. COR. ANDERSON DLC 50.

SCALE: 1" = 1320'

FINAL PROOF SURVEY

UNDER

R-56977 R-7825

Application No. 58545 **Permit No.** 44142

IN NAME OF

FRANK GILMOUR

Surveyed May 3 & 13 **19** 85, **by** T. M. WARREN

DFN-6LL-30
14-67 SE¼

BWB