


T. 9S., R. 3W., W.M.

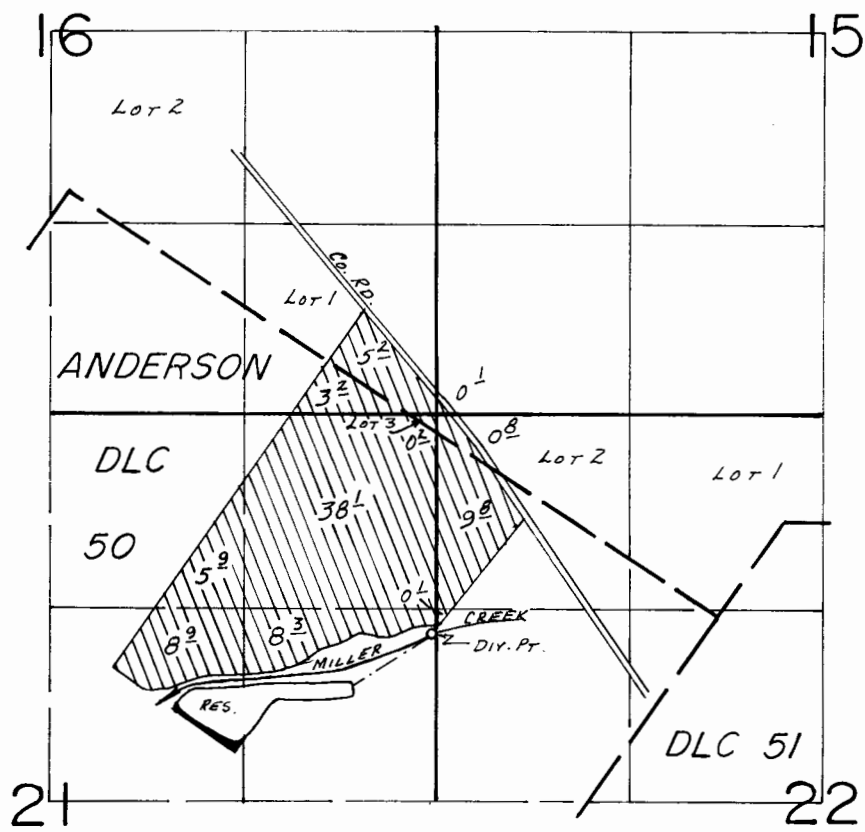

Div. Pt. Loc.: 110'S. & 1950'W. FROM E. COR. ANDERSON DLC 50.

SCALE: 1"=1320'

### FINAL PROOF SURVEY UNDER

R-56977                      R-7825  
 Application No. 585.45... Permit No. 44142.....  
 IN NAME OF  
 .....FRANK GILMOUR.....

Surveyed May 3 & 13 19.85, by T.M. WARREN....

DFN-6LL-30  
14-67SE/4

BWB