


T.9S., R.3E., W.M.

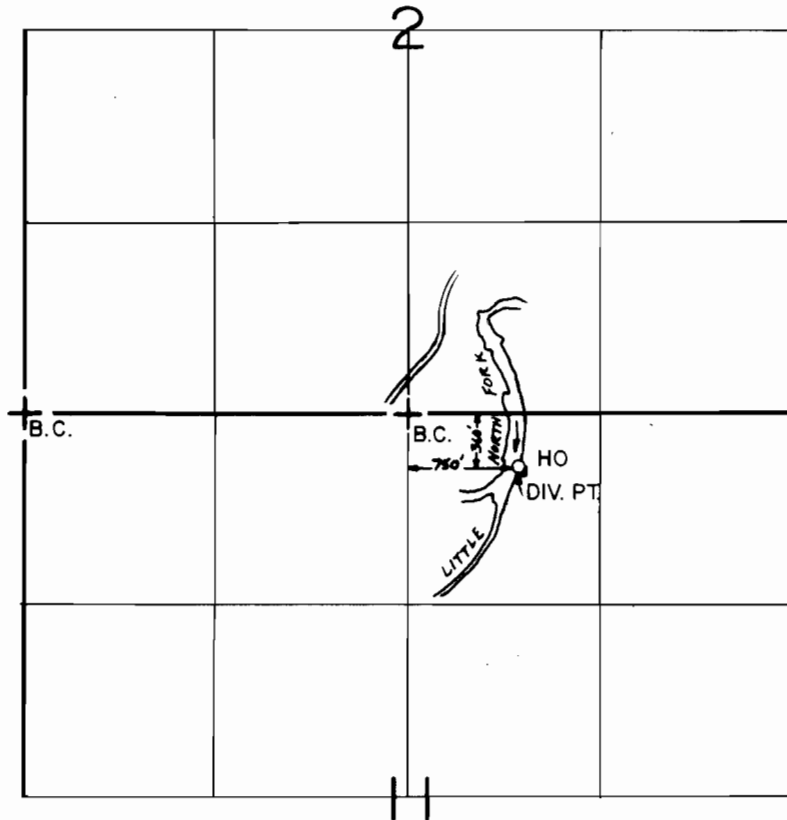

SCALE: 1" = 1320'

FINAL PROOF SURVEY
UNDER

Application No. 59185... Permit No. 44387.....

IN NAME OF

CARL & EILEEN WHALEY

Surveyed APRIL 25 1985, by P. R. PAGTER.....