


# T. 4S., R. 1W., W.M.

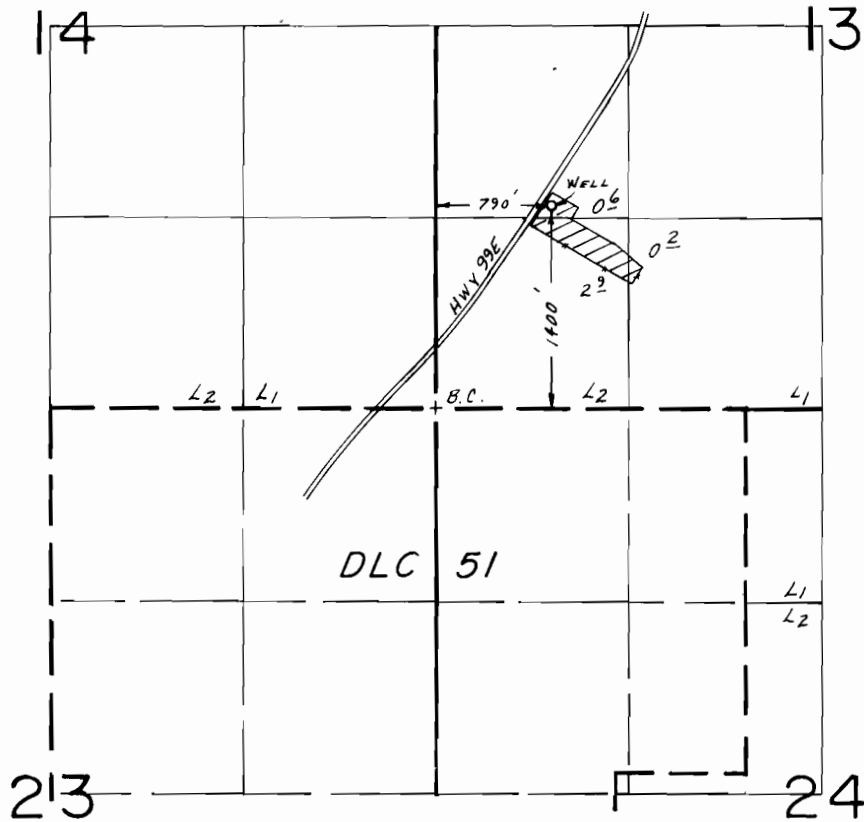

SCALE: 1" = 1320'

## FINAL PROOF SURVEY UNDER

Application No. G-10785 Permit No. G-9863....  
IN NAME OF

JACK A. or M. LORAINE COBB

Surveyed Mar. 18.... 19.86, by T.M. WARREN.....