


T. 6S., R. 3W., W.M.

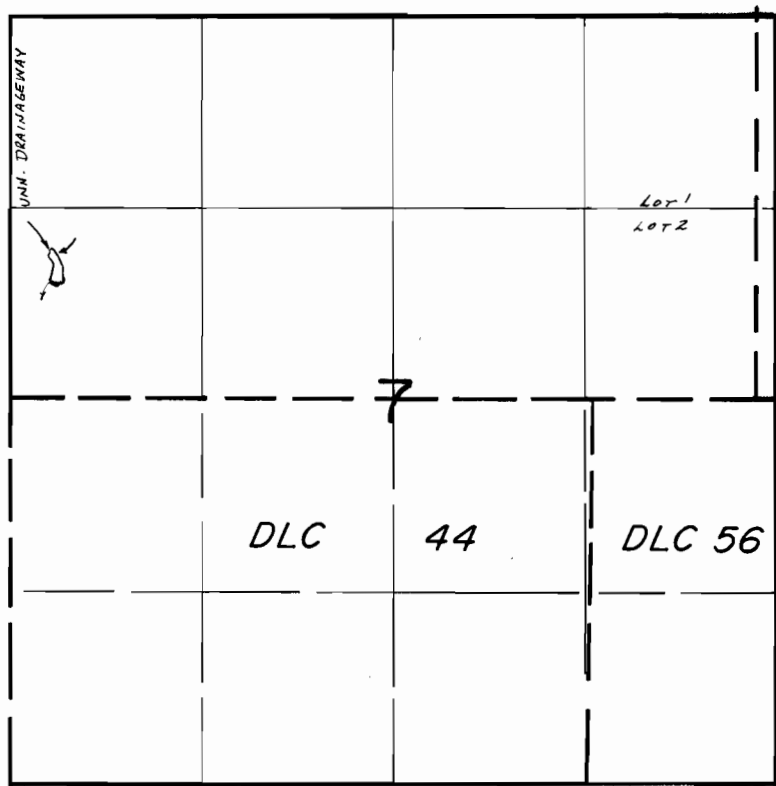

Div. Pt. Loc.: 1850'S. & 320' E. FROM NW COR. SEC. 7

SCALE: 1"=1320'

FINAL PROOF SURVEY UNDER

R-64068 R-8521
Application No. 64069 Permit No. 47105
IN NAME OF

SEVEN SPRINGS FARM

Surveyed Oct. 3, 1985, by B.W. BISHOP