


T. 3 N. R. 9 W. WM.

SCALE 1" = 400'

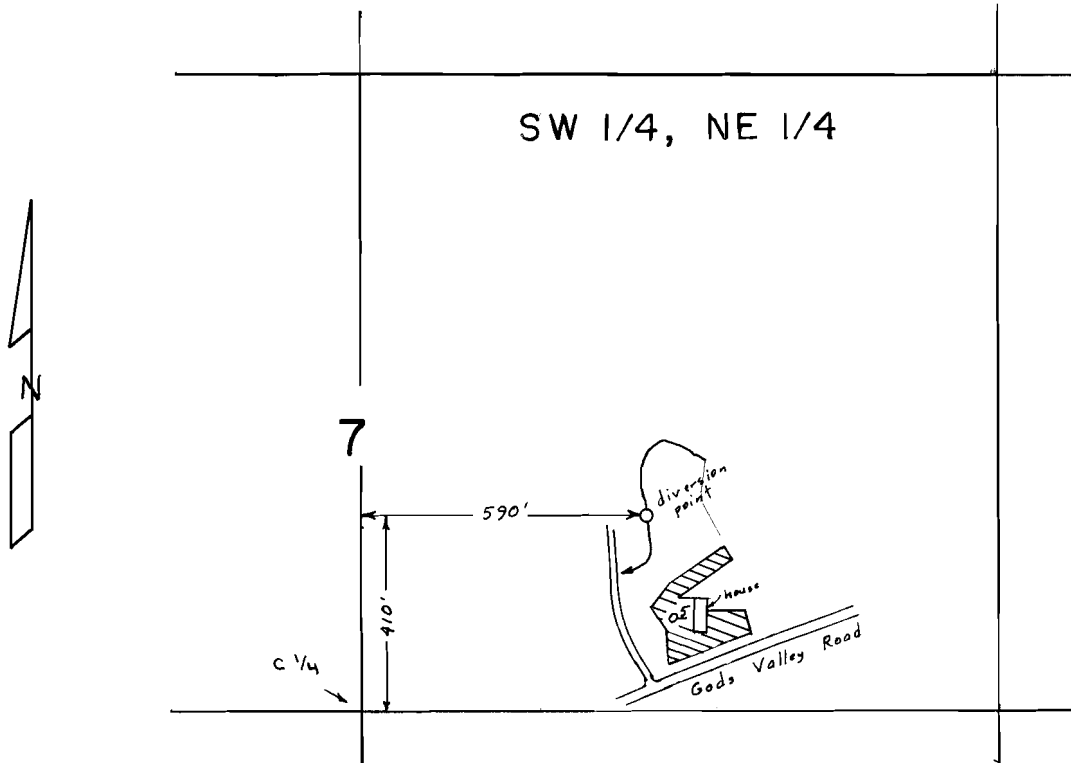

FINAL PROOF SURVEY
UNDER

Application No. 59807 Permit No. 44878
IN NAME OF

THE ESTATE OF JAMES R. GREEN

Surveyed OCT. 25 1983, by PAGTER, P.