


T.2S., R.2W., W.M.

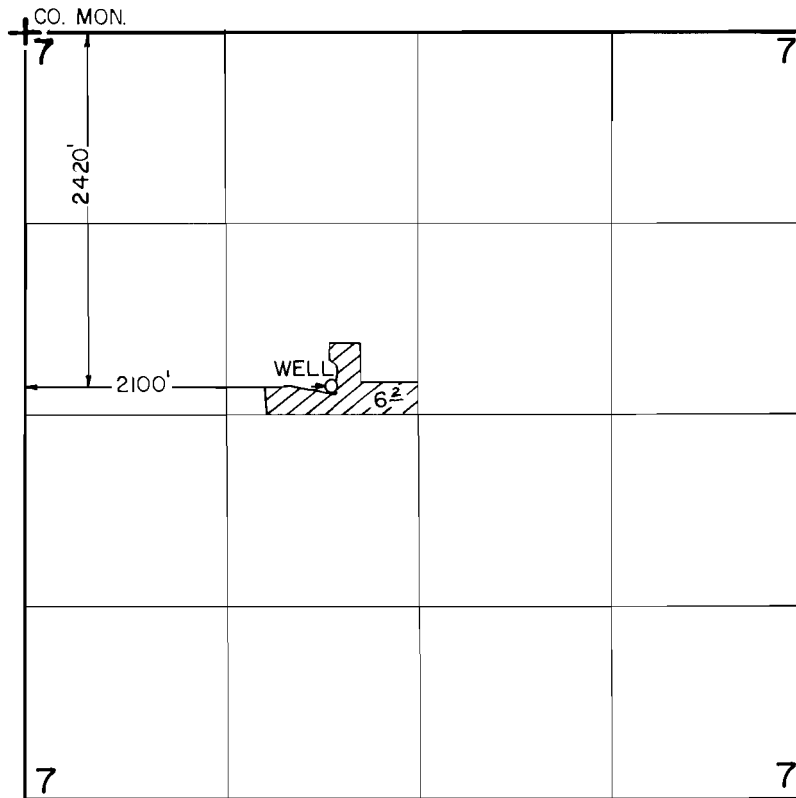

SCALE: 1" = 1320'

FINAL PROOF SURVEY UNDER

Application No. G-7867 Permit No. G-7289
IN NAME OF

DELL M. SQUIRE

Surveyed AUG. 2 1985, by T. M. WARREN