


T. 30 S. R. 15 W. W. M.

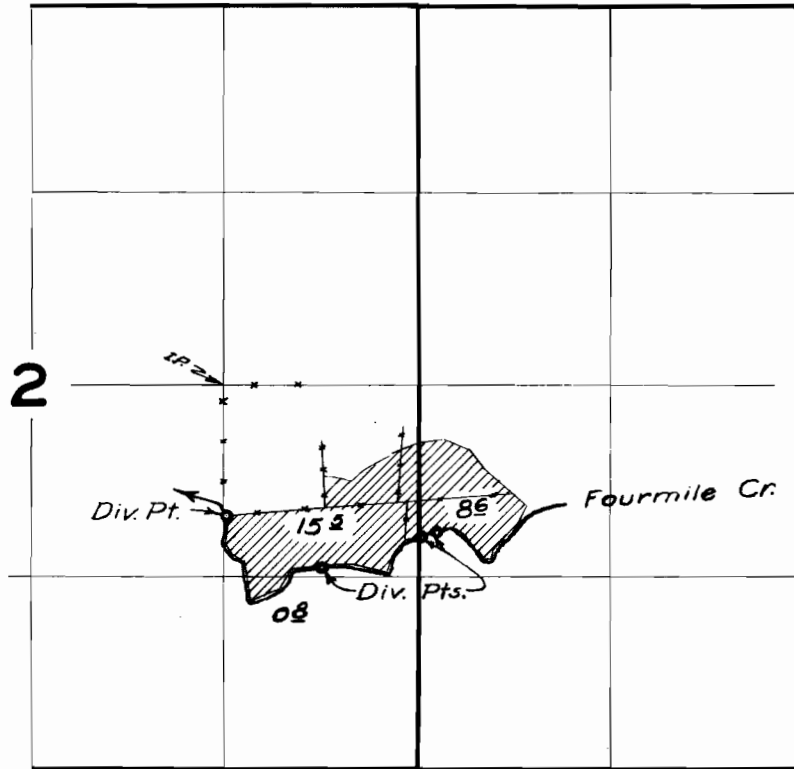

FINAL PROOF SURVEY
UNDER

Application No. 27285 Permit No. 21462
IN NAME OF

Dave Nelson

Surveyed 20 May 1958, by Tom B. Fish