


N.

RECEIVED
STATE ENGINEER
SALEM, OREGON

RECEIVED
SEP 25 1968
STATE ENGINEER
SALEM, OREGON

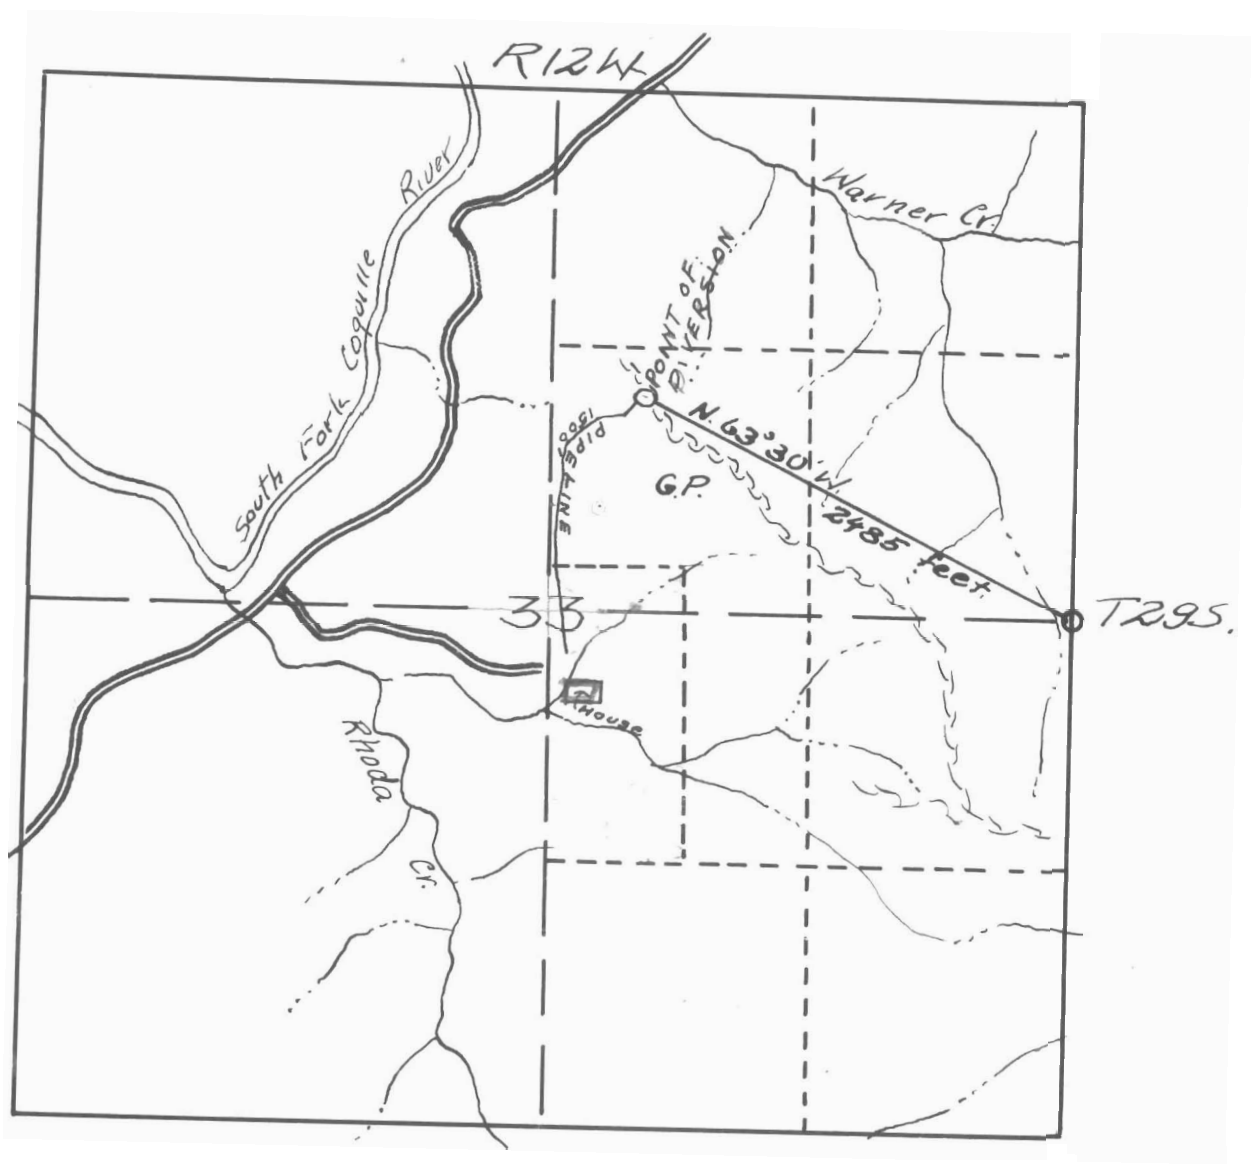

Reservoir & Pipe Line.

mit No. 45455
3.39/22