


T.28S., R.13 W., W.M.

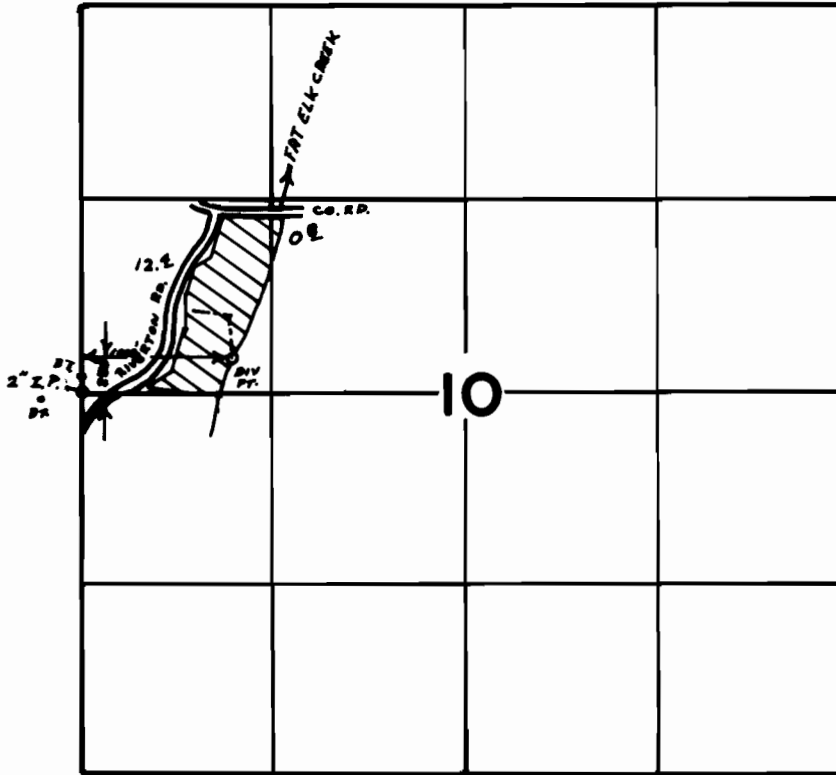

SCALE: 4" = 1 mile

**FINAL PROOF SURVEY**  
UNDER

Application No. 52119..... Permit No. 37821.....  
IN NAME OF

.....*Security Bank*.....

Surveyed O.C.T. 8, 1979, by S. DONALDSON