


T. 25 S., R. 13 W., W. M.

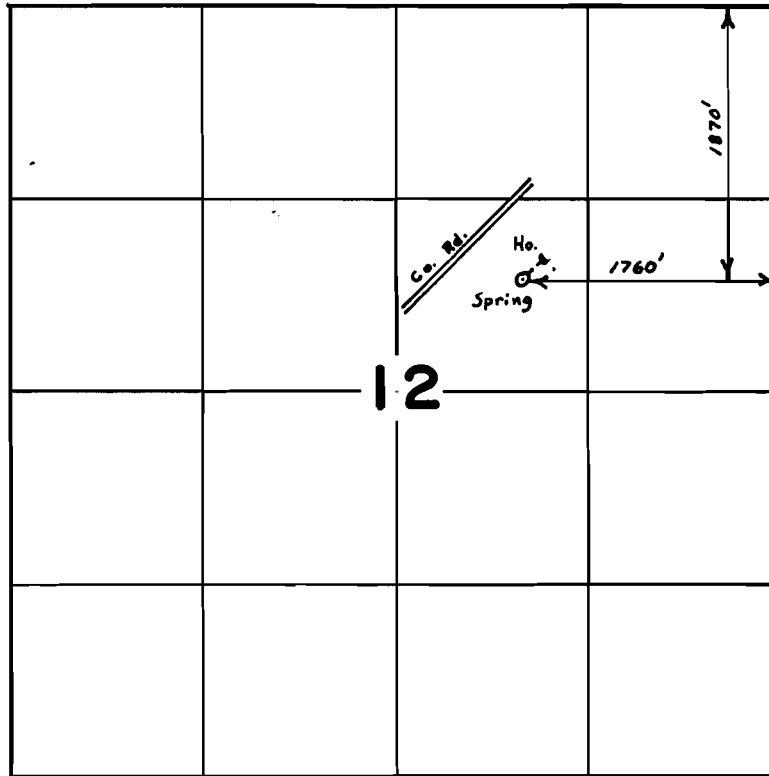

SCALE : 4" = 1 mile

FINAL PROOF SURVEY
UNDER

Application No. 57029. Permit No. 42746.
IN NAME OF

..... M. J. & M. KROMMINGA

Surveyed NOV. 15, 1978, by S. DONALDSON