


# T. 26 S., R. 12 W., W.M.

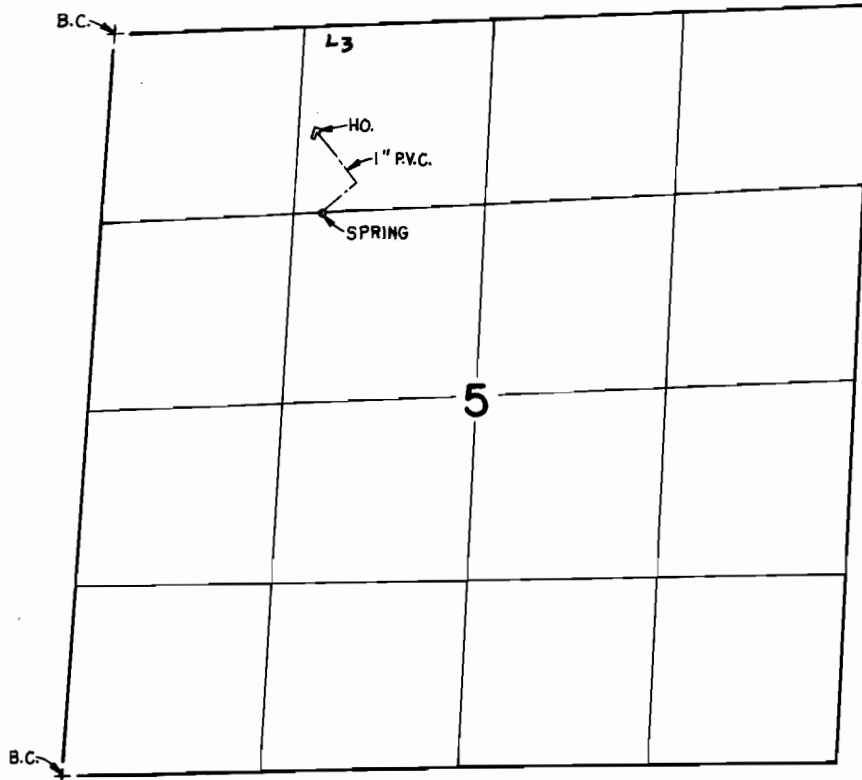

SPRING LOCATED 1,225'S. & 1,415'E. FROM N.W. CORNER SECTION 5

SCALE: 4" = 1 mile

## FINAL PROOF SURVEY UNDER

Application No. 58966... Permit No. 44451.....  
IN NAME OF

.....DEELDA MAE MOREY.....

Surveyed OCT. 26, 1983, by L. CASHION.....