


T.26S., R.12W., W.M.

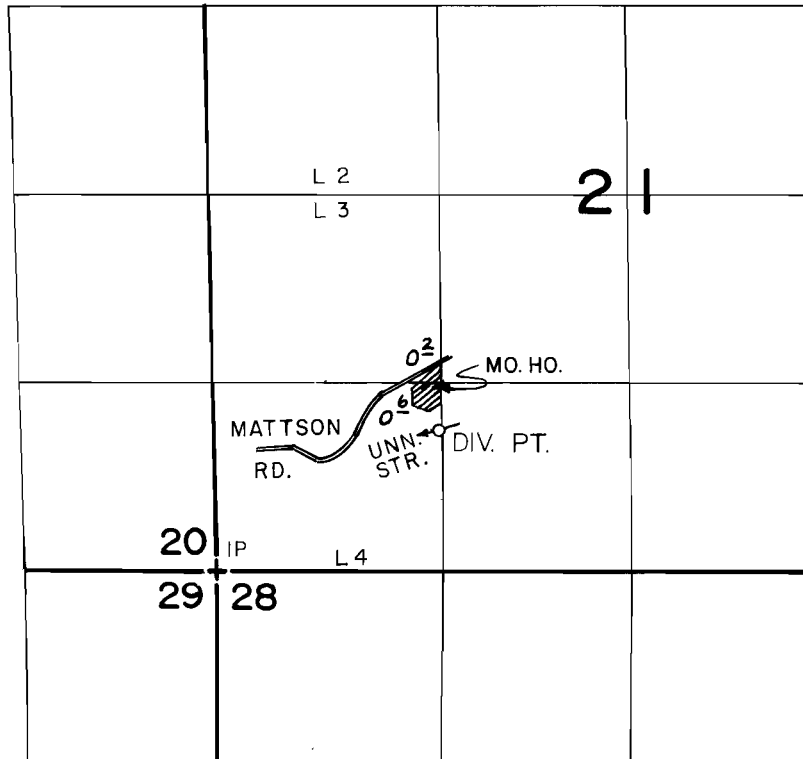

DIV. PT. LOC. 970' N. and 1520' E. from SW COR. SEC 21

SCALE: 4" = 1 mile

FINAL PROOF SURVEY UNDER

Application No. 59251... Permit No. 44584...
IN NAME OF

DALE W. & DOROTHY M. PETERSON

Surveyed OCT. 25 1983, by L E Cashion

REV. 03/13/86 JMS

41011 180 234 D/PTS 1983 R-A JEC