


T. 26S., R. 3W., W.M.
SEC. 1

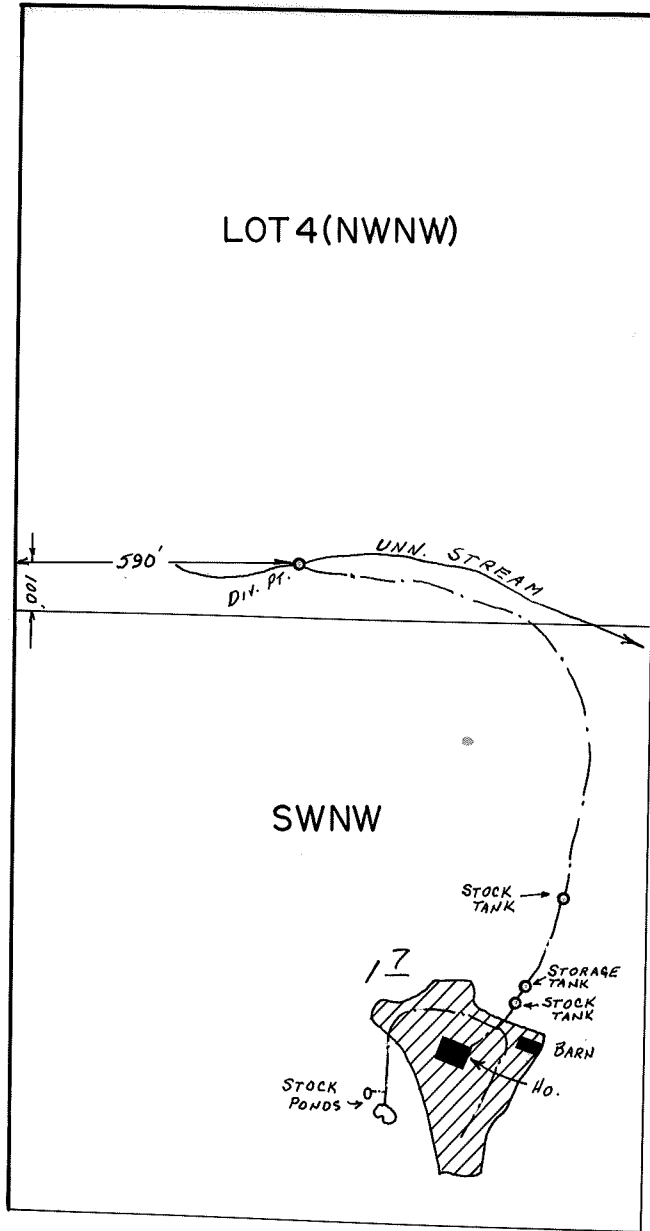

SCALE: 1" = 400'

FINAL PROOF SURVEY
UNDER

Application No. 48729... Permit No. 36529.....
IN NAME OF

.....DONALD B. NUNLEY.....

Surveyed MAY. 8.... 19.80, by J.S. DONALDSON