


RECEIVED

MAY 5 1978

WATER RESOURCES DEPT.
SALEM, OREGON

T.22S.R.8 & 9W.W.M.

Application No. 57380
Permit No. 13188

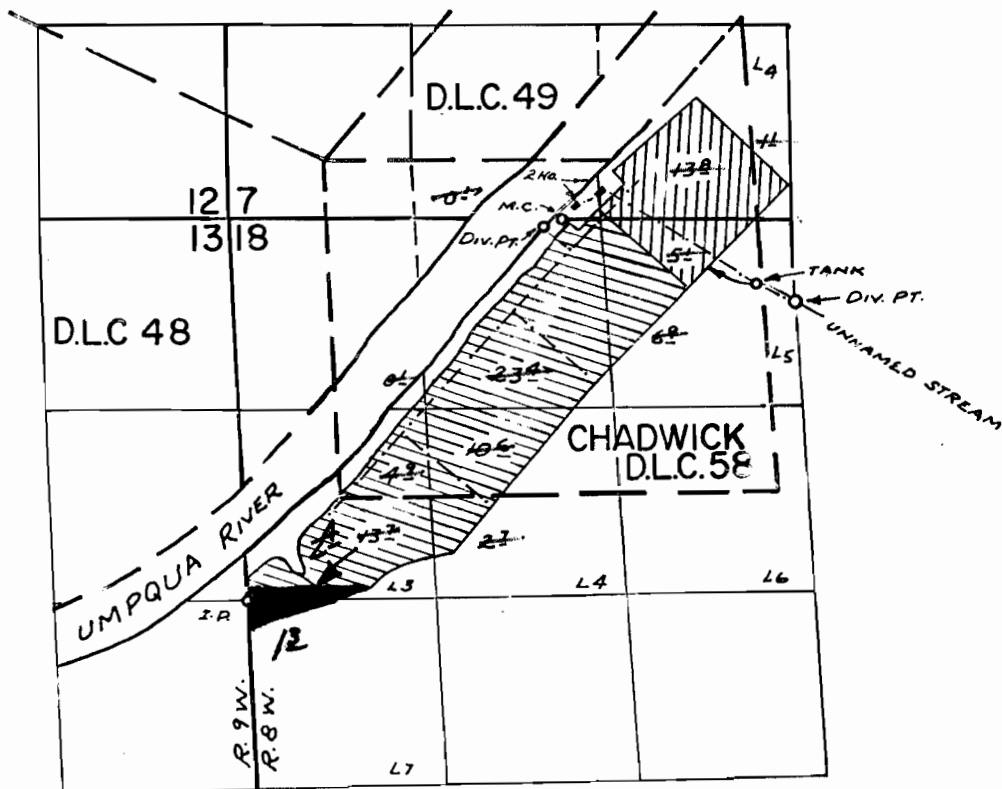

DIV. PTS. LOC: RIVER - 50'S. & 400'W ; UNNAMED STREAM - 500'S. & 1200'E. FROM N 1/2 COR. SEC. 18

FINAL PROOF SURVEY
UNDER

Application No. ~~57380~~ 50550 Permit No. ~~40357~~ 38166
IN NAME OF

FOR REST. SOLDMON

Surveyed MAY 11, 1976, by R. MUCKEN