




T. 32 S., R. 3 W., W.M.

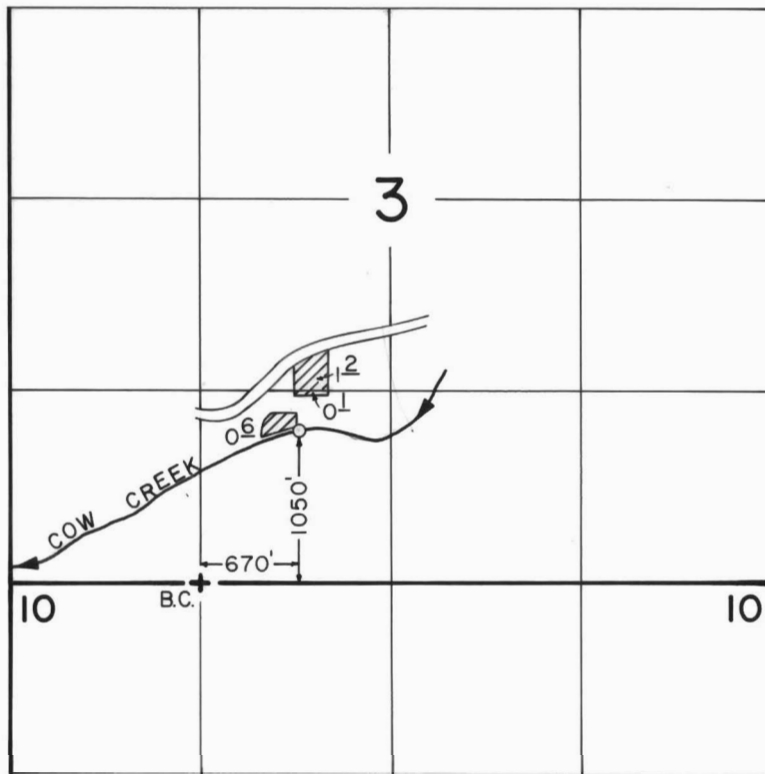

SCALE: 1"=1320'

FINAL PROOF SURVEY
UNDER

Application No. 58333... Permit No. 44174.....
IN NAME OF

.....**JOE & DIANE RUSSELL**.....

Surveyed DEC. 16... 1984, by L. CASHION.....