


T.38S. R.20E. W.M.

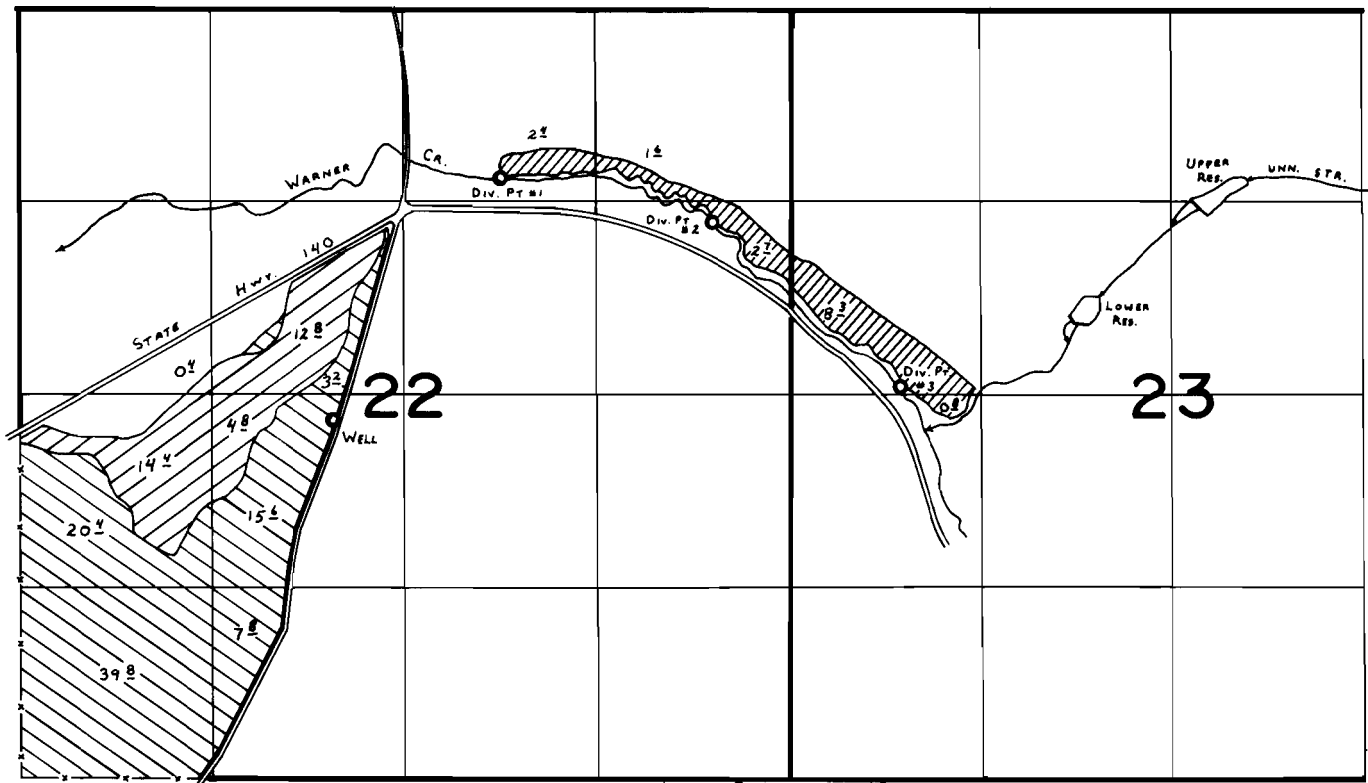

-  - PRIMARY IRR. (APP. 51526)
-  - PRIMARY IRR. (APP. G-8274)
-  - SUPPLEMENTAL IRR. (APP. G-8274)

UPPER RES. 1350' S. & 2800' E.
LOWER RES. 2150' S. & 1960' E.
Div. Pts. Loc: #1-1160' S. & 2000' W.

#2-1460' S. & 540' W.
#3-2590' S. & 750' E. } ALL FROM N.E. COR. SEC. 22.

WELL Loc: 2460' N. & 2150' E. fr. S.W. COR. SEC. 22.

FINAL PROOF SURVEY UNDER

Application No. **G-8274** **G-7698**
51526 Permit No. **38881**.....
IN NAME OF

.....*Robert C. Cunningham*.....

Surveyed June 6, 1980, by *C. L. Hughes*.....