


Sec. 22, T.10S., R.3W., W.M.

10 3W 22

1" = 400'

See Map 10 3W 15

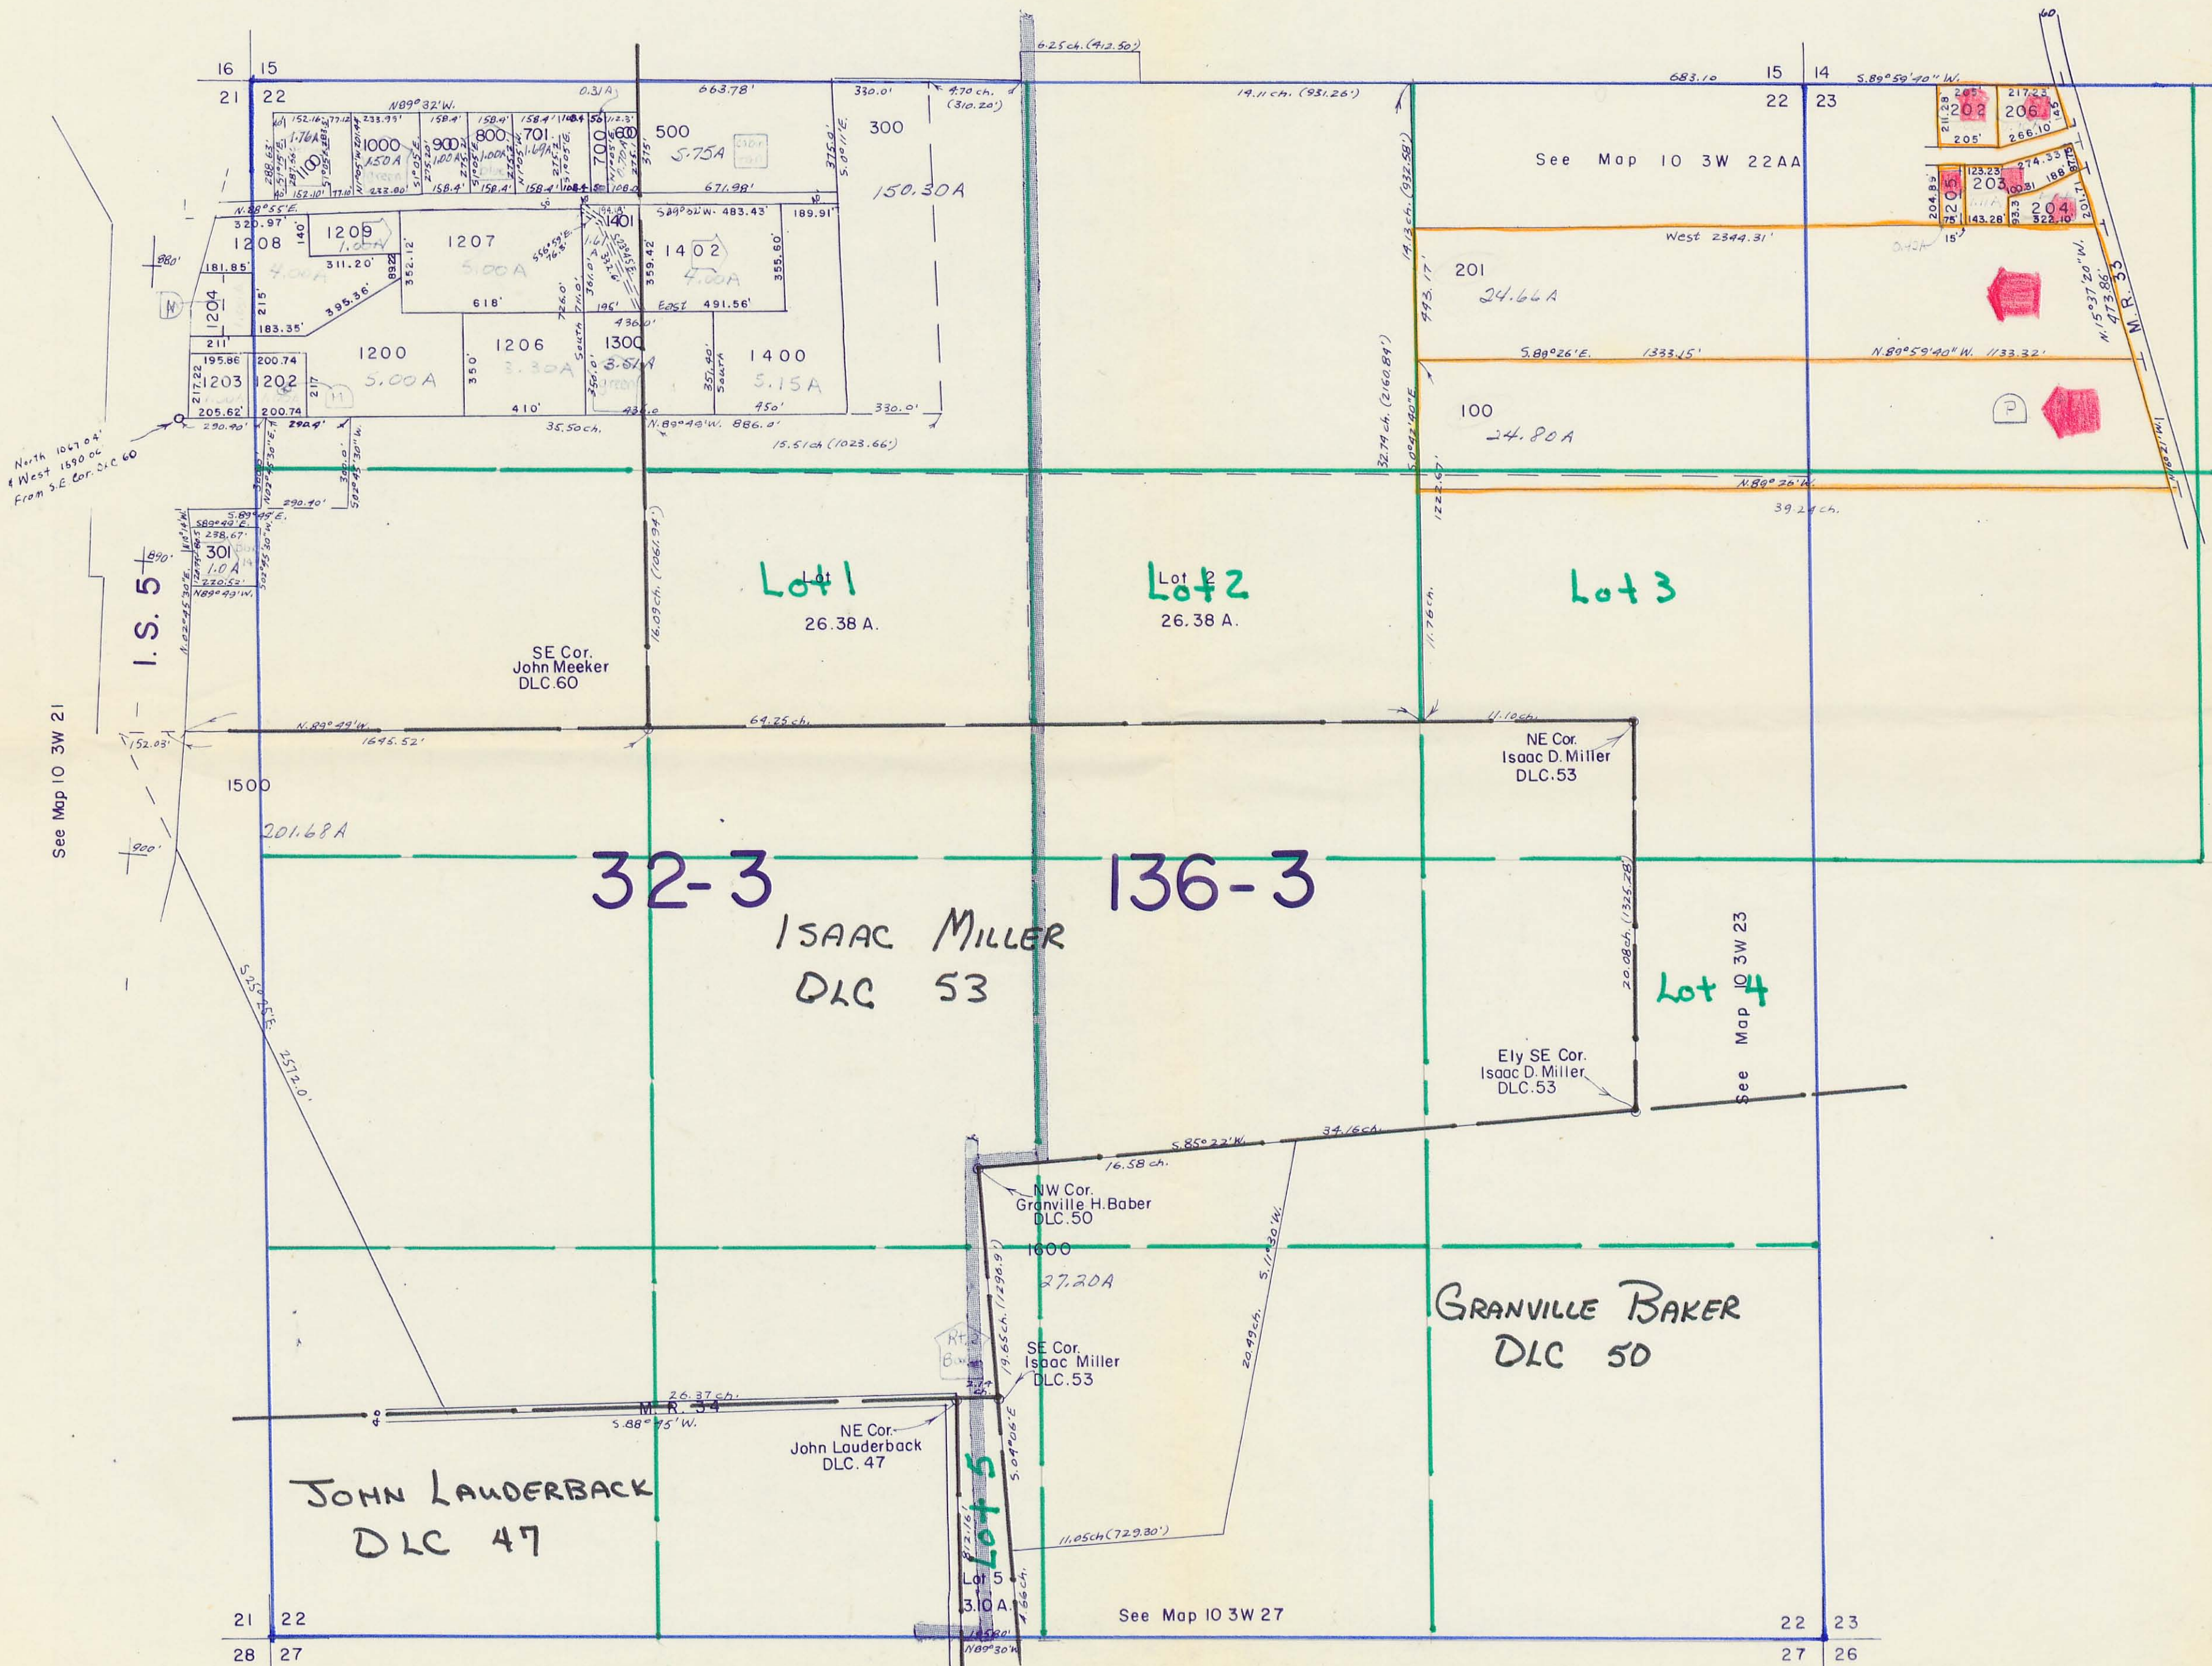

North 1067.04' & West 1890.00' From S.E. Cor. DLC. 60

See Map 10 3W 21

I.S. 5

1500

201.68A

32-3
ISAAC MILLER
DLC 53

136-3

JOHN LAUDERBACK
DLC 47

NE Cor.
John Lauderback
DLC. 47

Lot 5

Lot 5
3.10A

See Map 10 3W 27

NE Cor.
Isaac D. Miller
DLC. 53

Ely SE Cor.
Isaac D. Miller
DLC. 53

GRANVILLE BAKER
DLC 50

Lot 4

See Map 10 3W 23


See Map 10 3W 22AA

10 3W 22

Sec. 23, T.10 S., R.3 W., W. M.

10 3W 23

1" = 400'

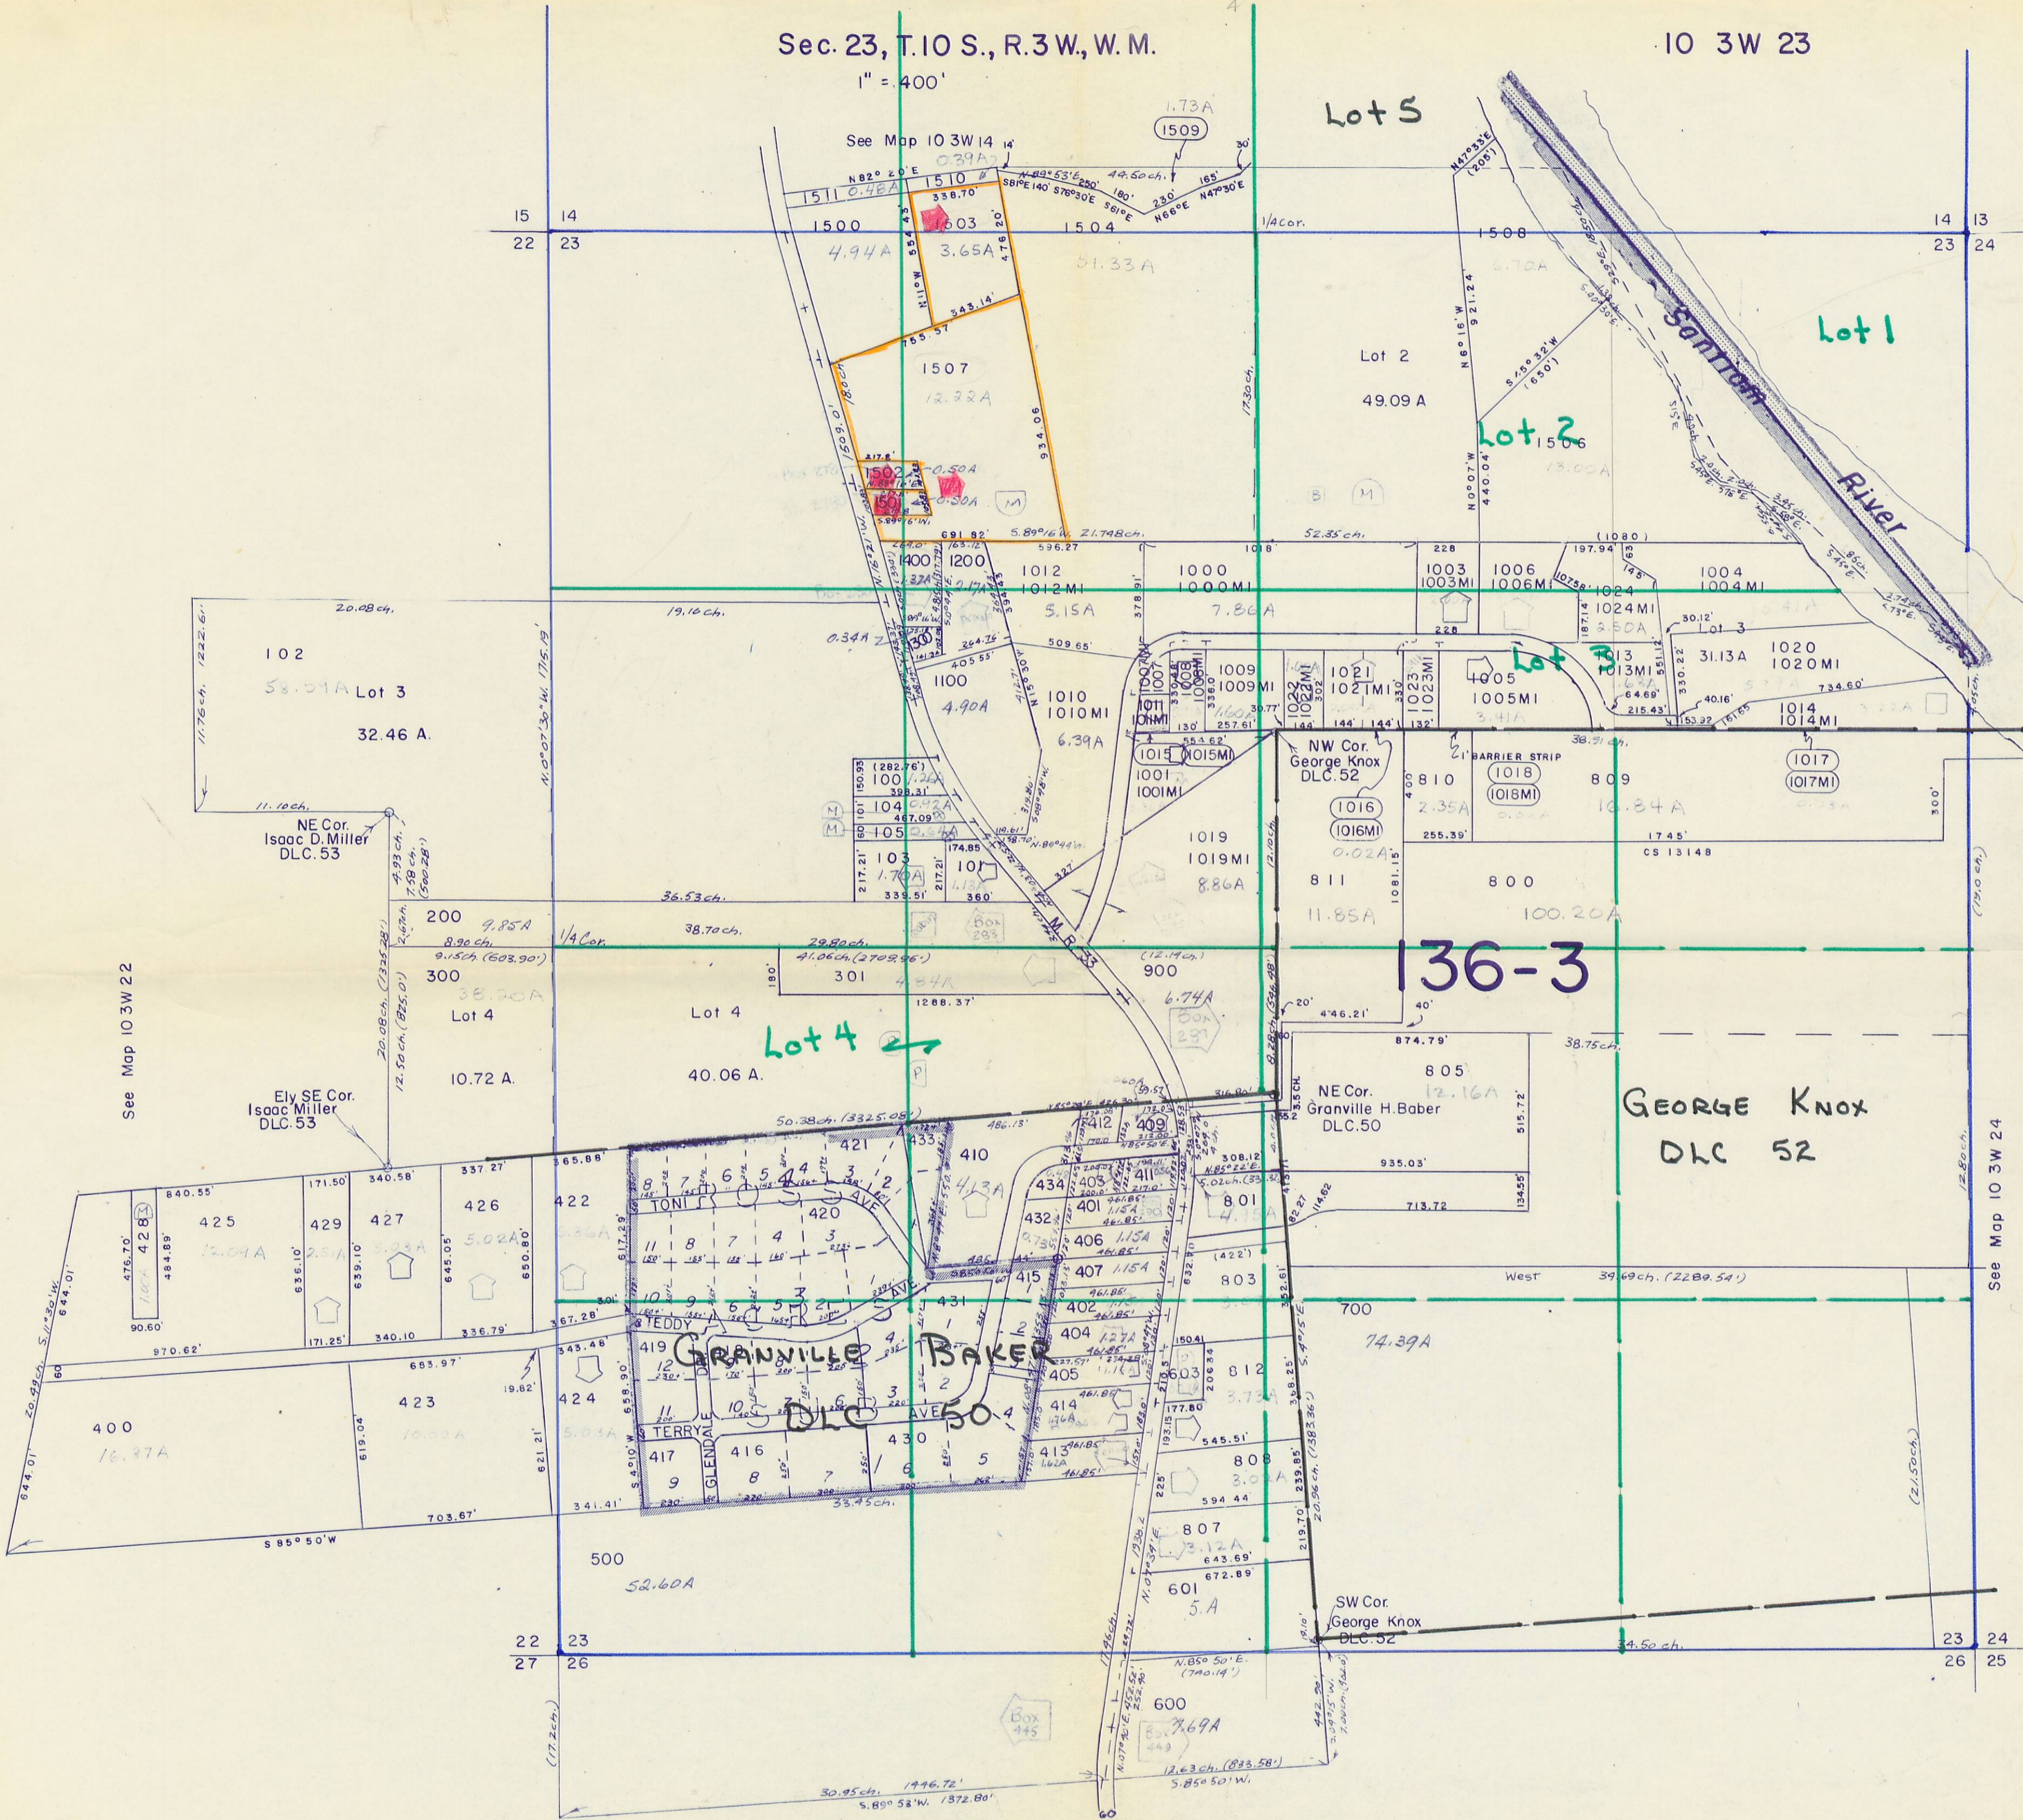


See Map 10 3W 22

See Map 10 3W 24

See Map 10 3W 26

10 3W 23

1" = 400'

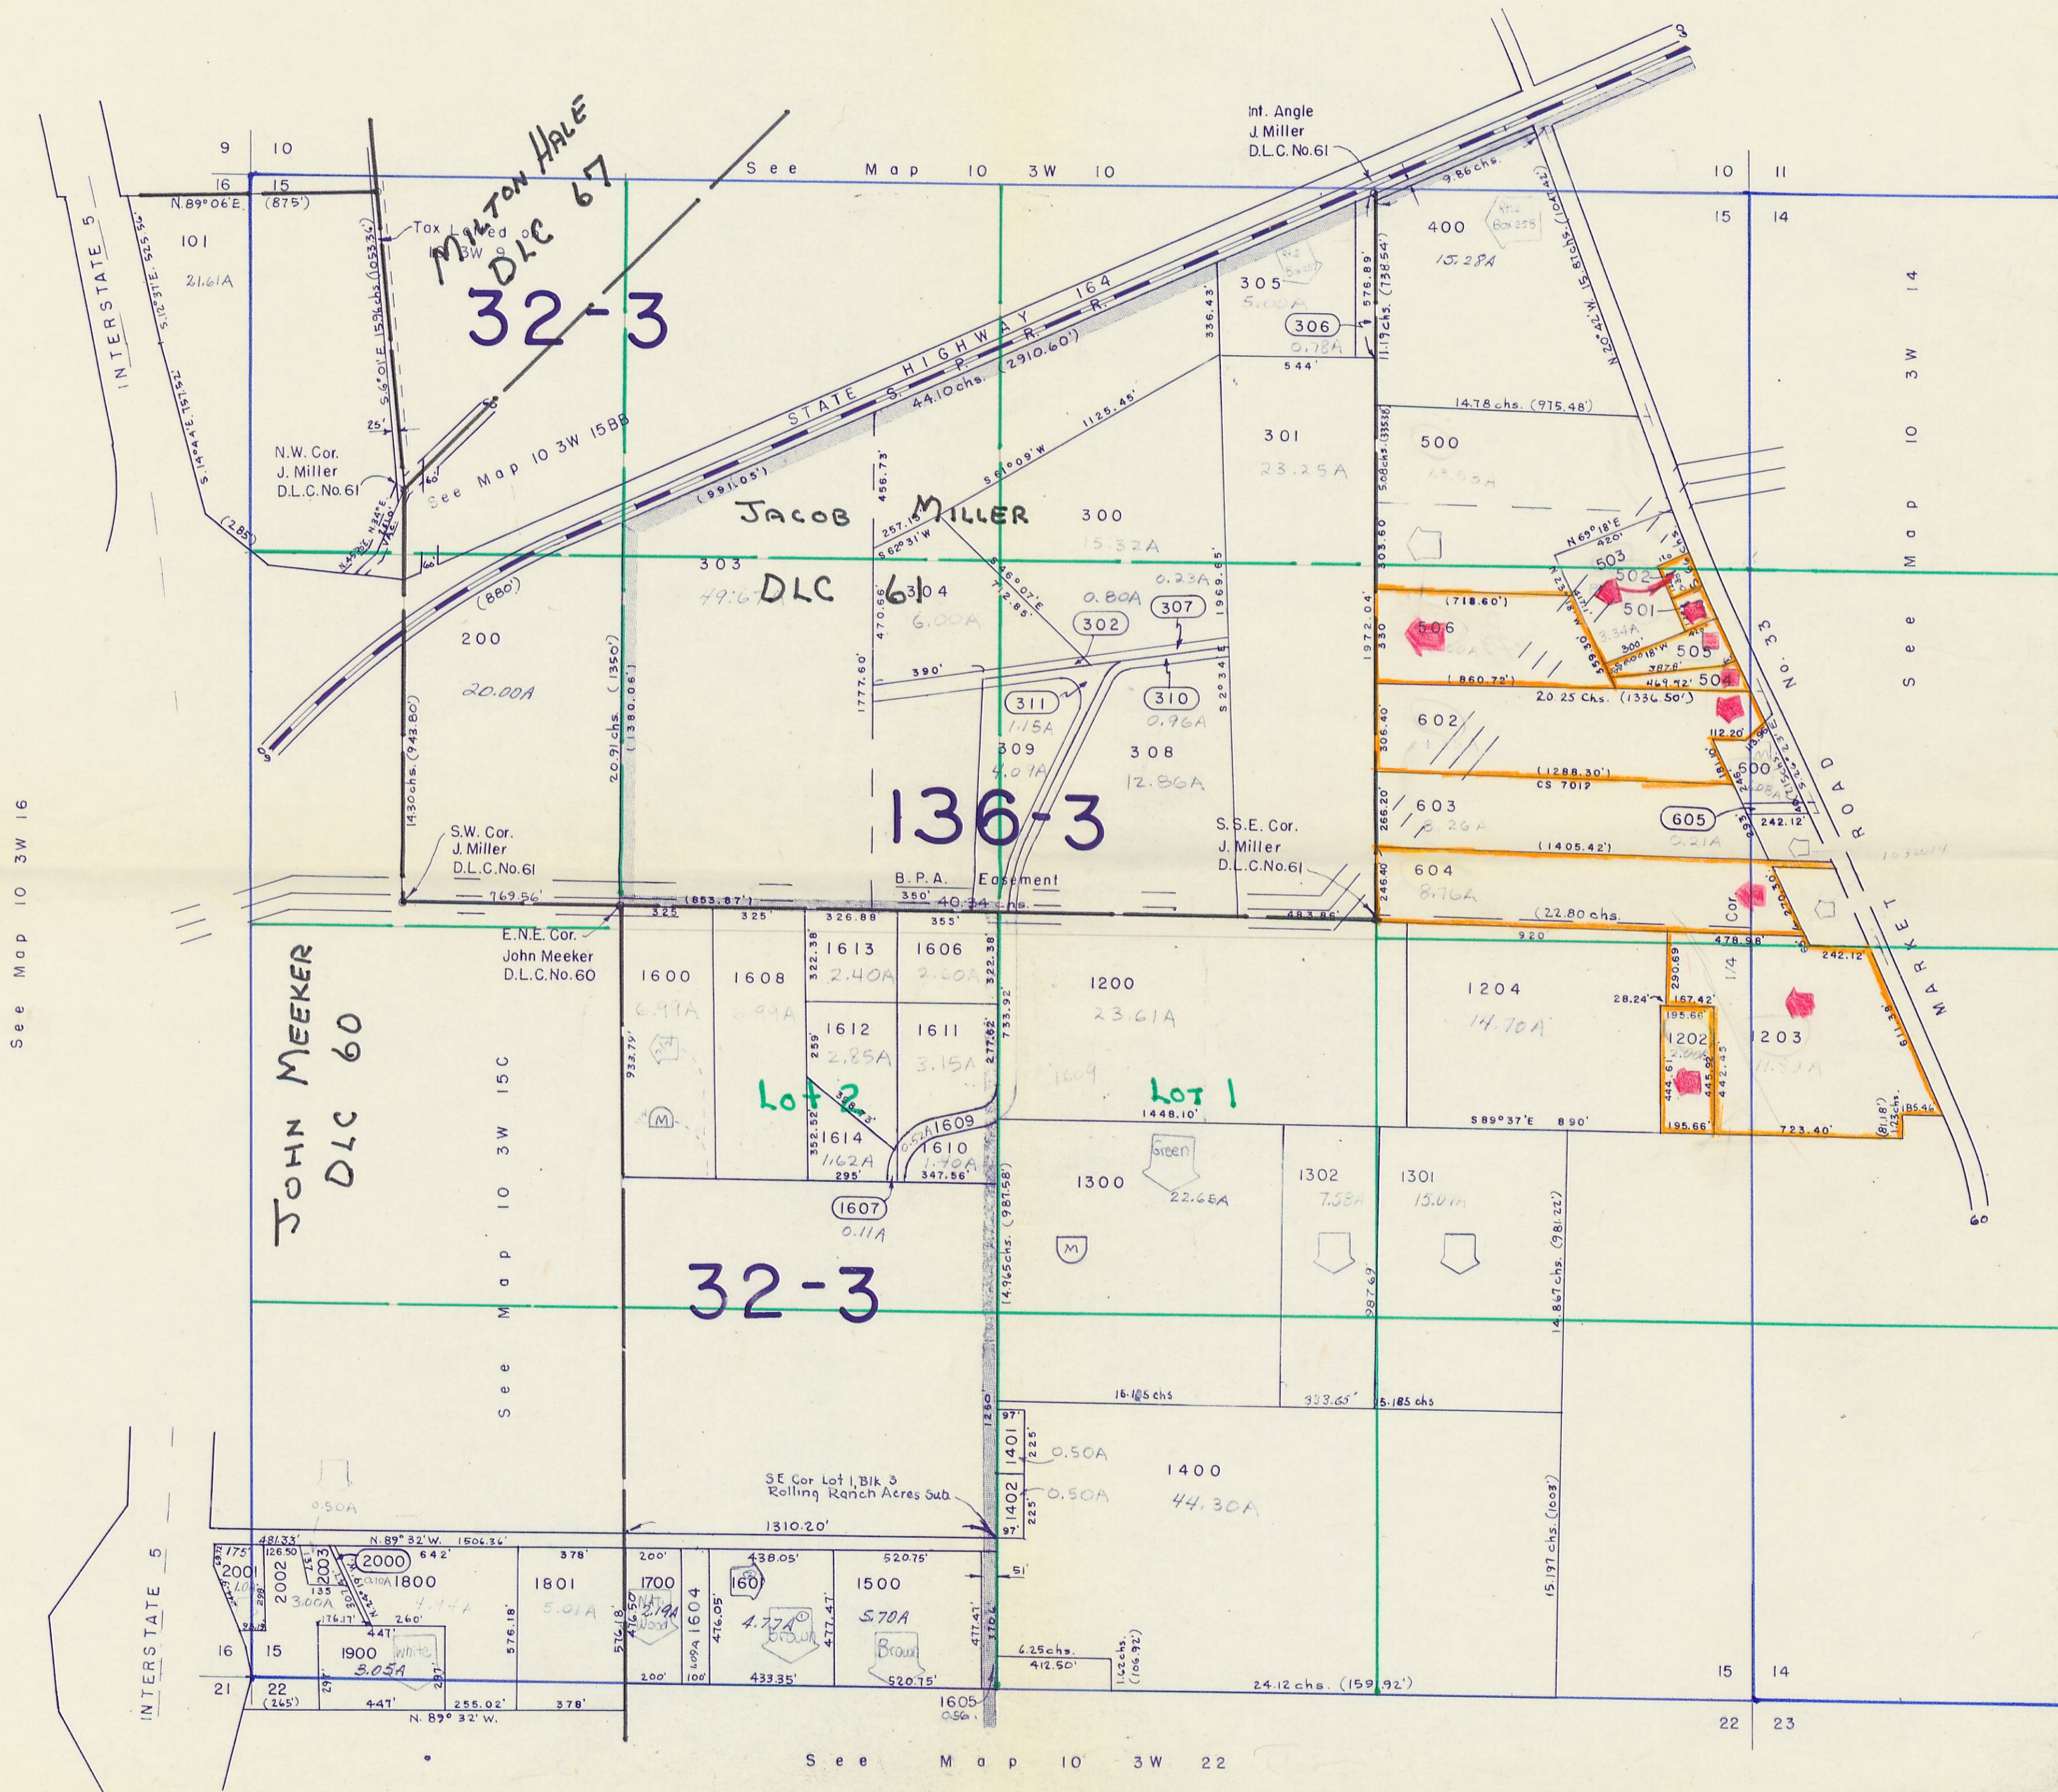

See Map 10 3W 16


See Map 10 3W 14

See Map 10 3W 15C

See Map 10 3W 22

1" = 100'



See Map 10 3W 15

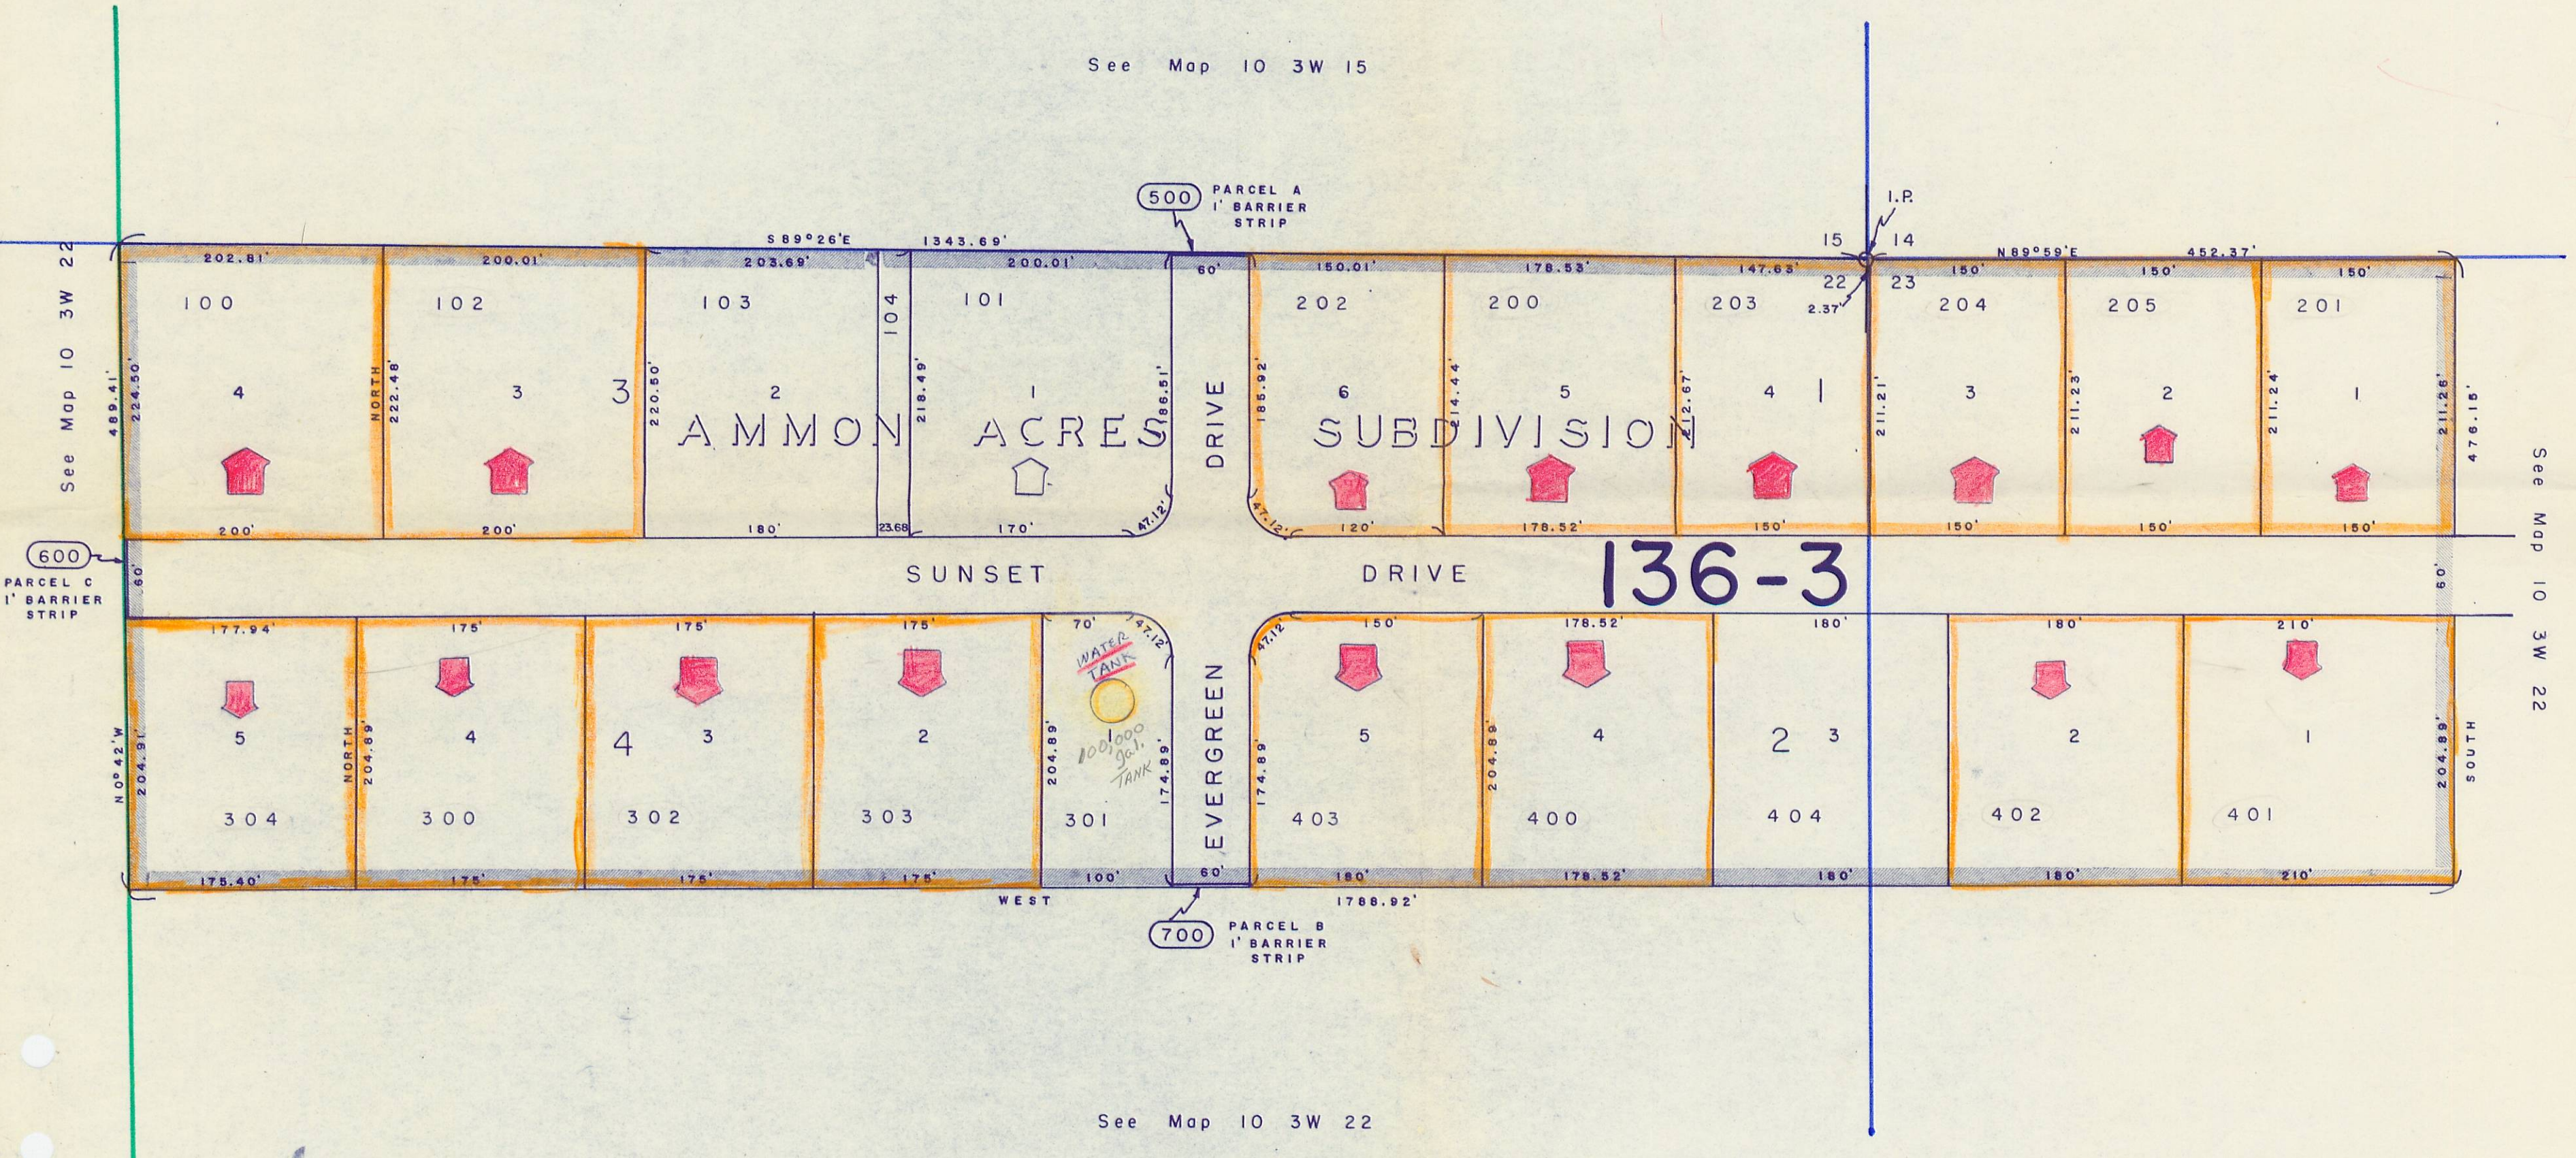

See Map 10 3W 22

1" = 400'

See Map 10 3W 11

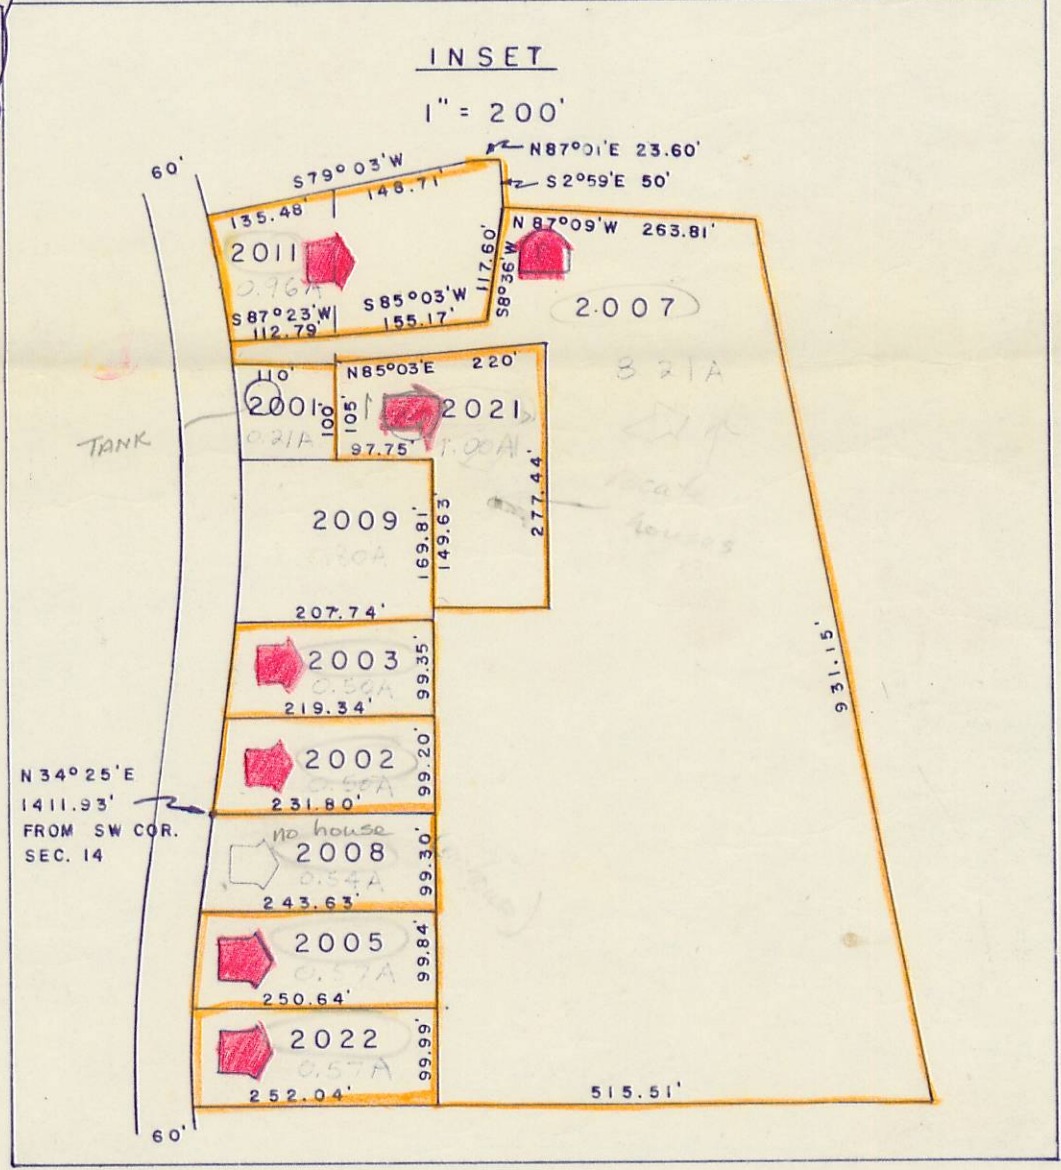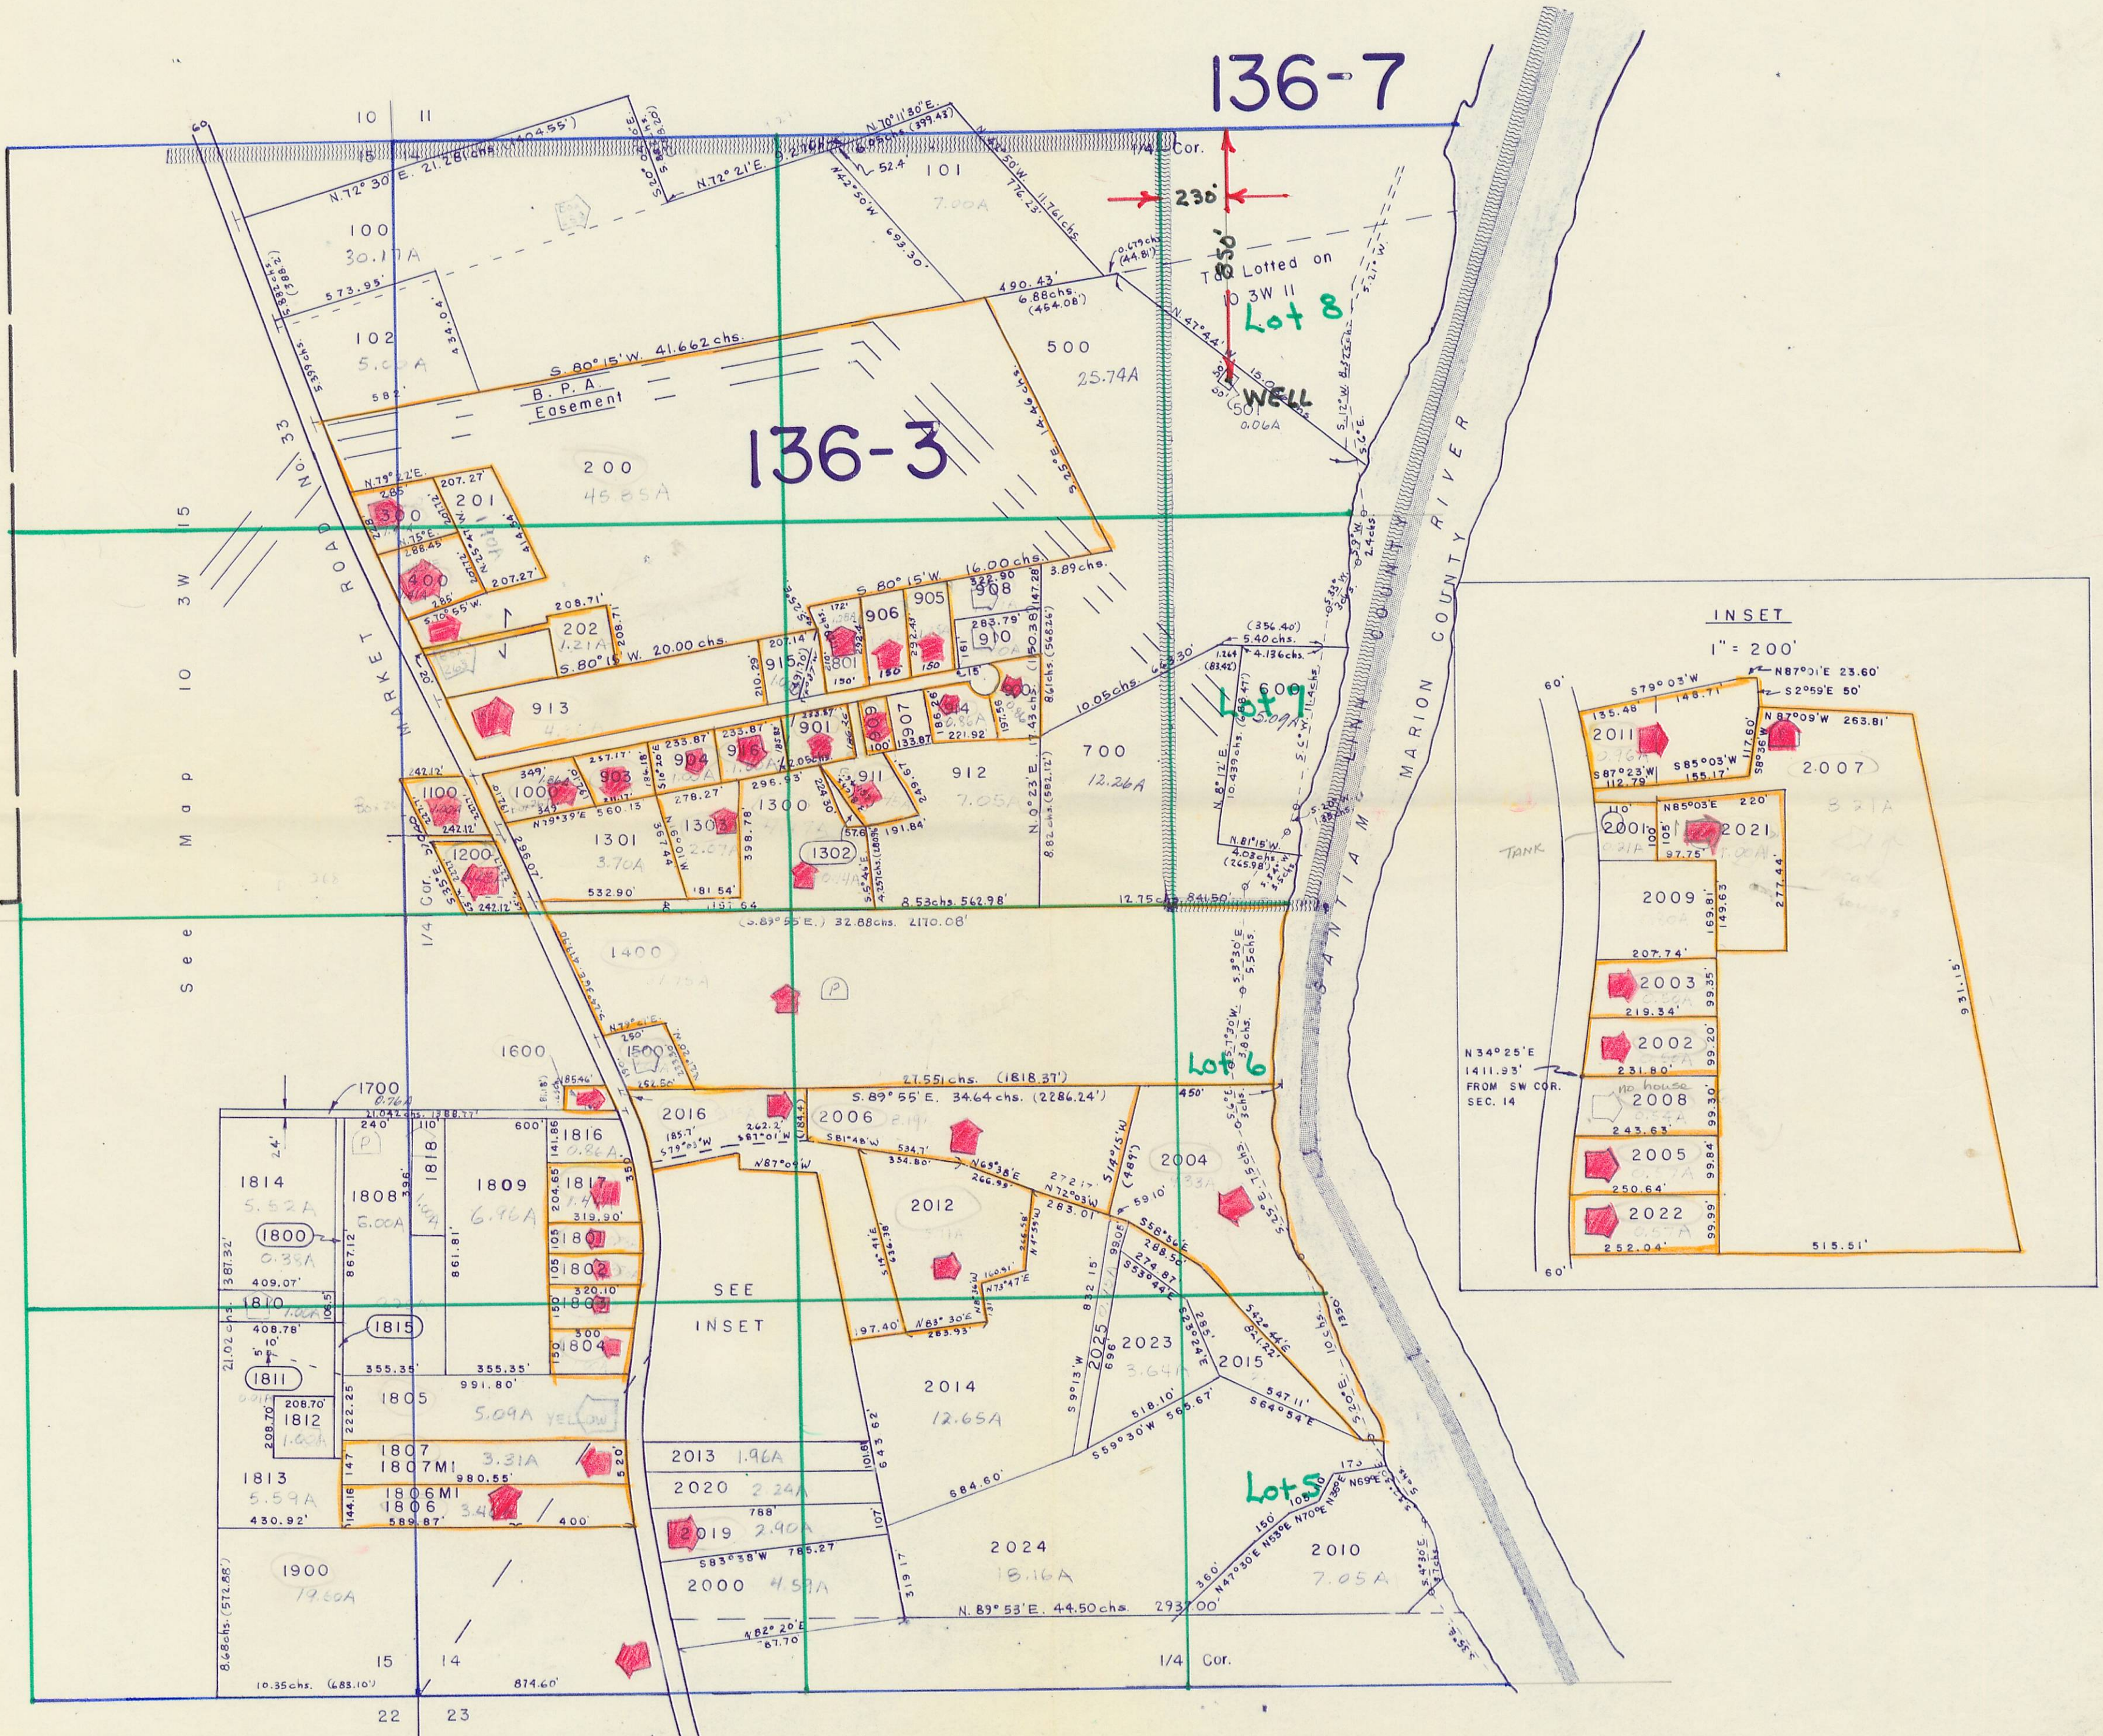

See Map 10 3W 23