


# T. 36 S. R. 1 W. W. M.

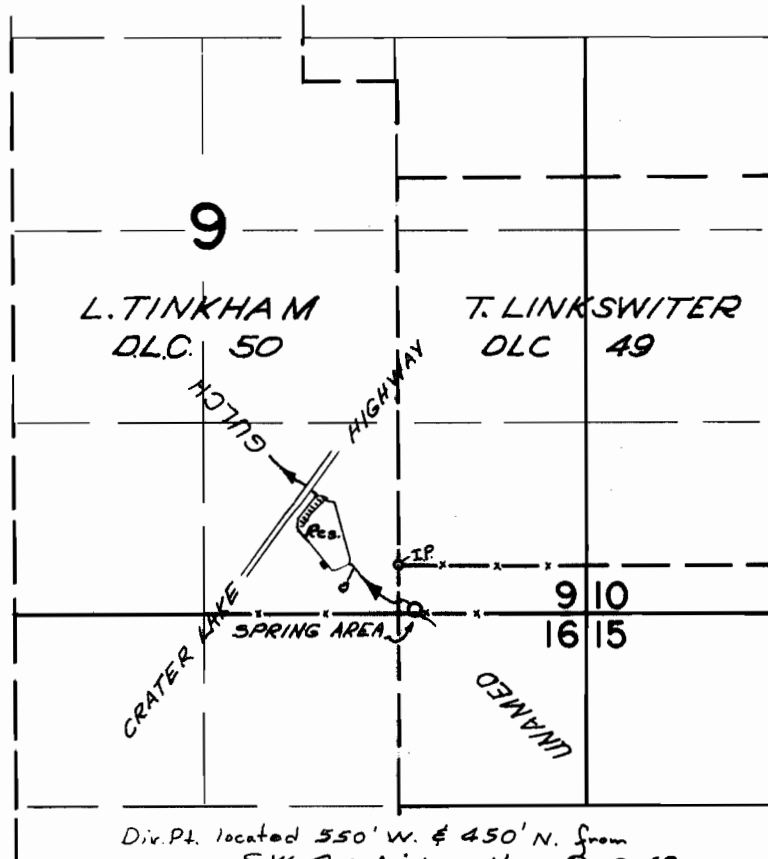

## FINAL PROOF SURVEY UNDER

39680                      29533  
Application No. ~~P-39681~~ Permit No. ~~P-3965~~  
IN NAME OF

GERALD W. & ROSIE MAYES

Surveyed JUNE 1, 1966, by V. GARNER