


T. 35 S., R. 4 W., W.M.

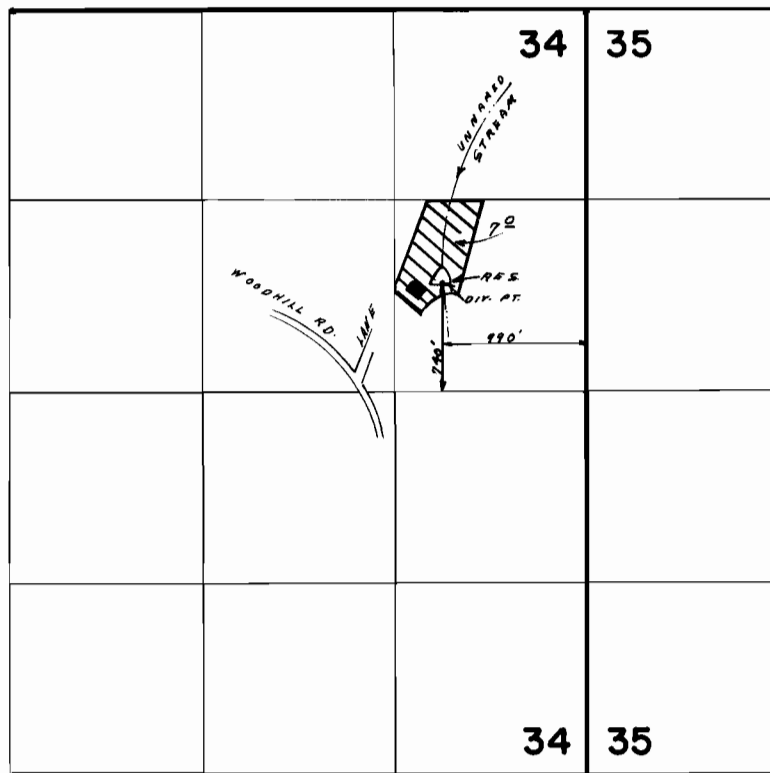

SCALE: 1" = 1320'

FINAL PROOF SURVEY
UNDER

R - 52438

R - 6315

Application No. 52439 Permit No. 39439

IN NAME OF

WILLIAM N. & GALE JOHNSON

Surveyed AUG. 15, 1985, by J. M. SCHMORDE