
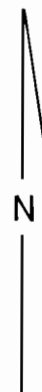


T. 35 S., R. 4 W., W.M.

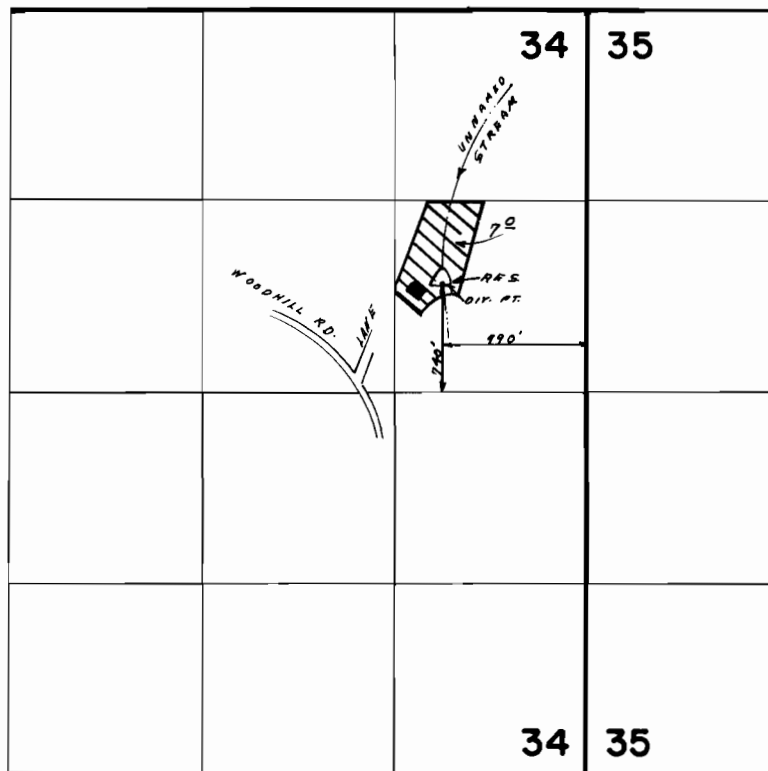

SCALE: 1" = 1320'

FINAL PROOF SURVEY
UNDER

R-52438 R-6315
Application No. 52439 Permit No. 39439
IN NAME OF

WILLIAM N. S. GALE JOHNSON

Surveyed AUG. 15, 1985, by J. M. SCHMORDE