


T.39 S., R.2 E., W.M.

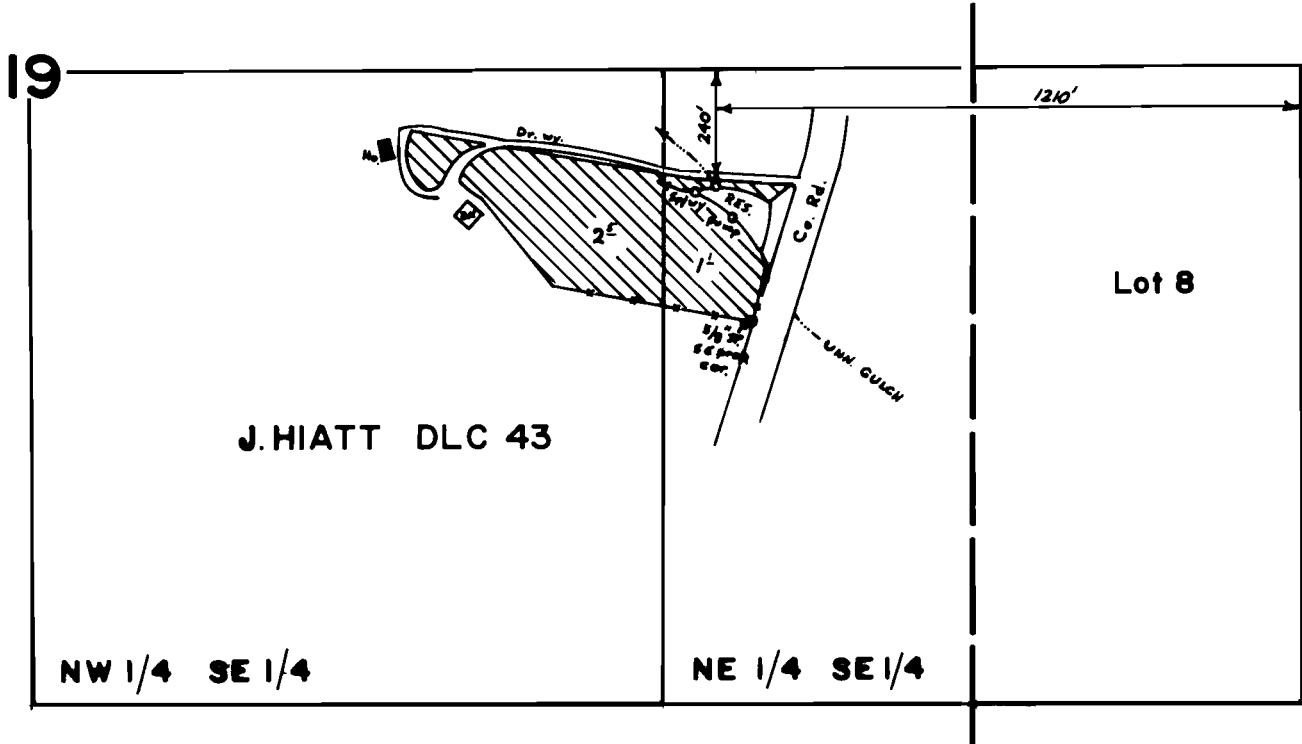

Scale 1" = 400'

FINAL PROOF SURVEY
UNDER

R-53615

R-6405

Application No. 53616... Permit No. 40112.....

IN NAME OF

..... ELAINE HENRY

Surveyed July 25, 1980, by B.R.SUND.....