


T. 38 S., R. 1 W., W.M.

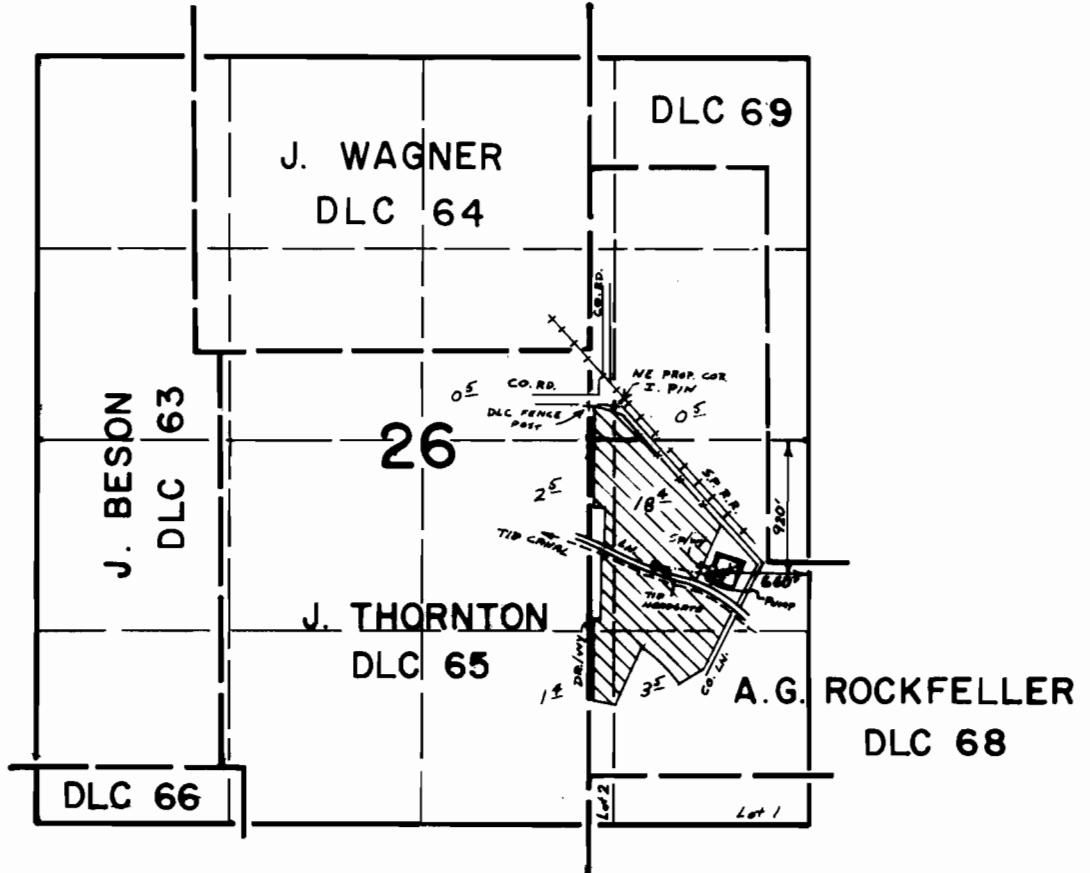

FINAL PROOF SURVEY
UNDER

R-54630 R-6529

Application No. 54631... Permit No. 40916.....

IN NAME OF

...MICHAEL... THORNILEY.....

Surveyed AUG. 25, 1981, by Bruce R. Sund.