


T. 36S. R. 3W. W. M.

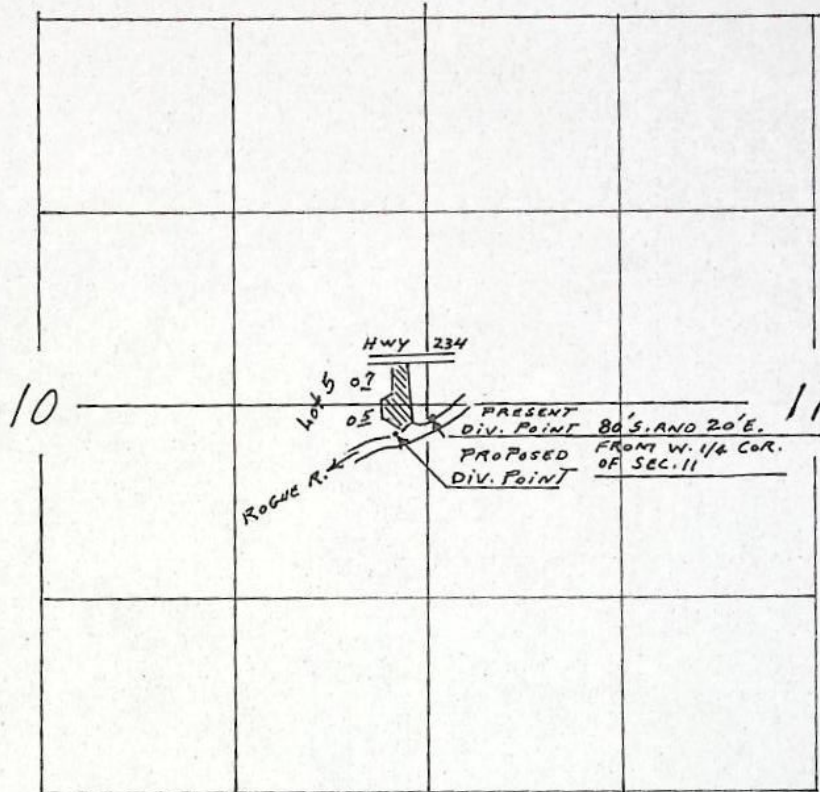

PROPOSED DIVERSION POINT IS LOCATED 200'S. AND 200'W. FROM THE E. 1/4 COR. OF SEC. 10

MAP TO ACCOMPANY APPLICATION OF CARTEE AND NAOMI WOOD FOR CHANGE IN POINT OF DIVERSION

RECEIVED

JUN 26 1975

STATE ENGINEER  
SALEM, OREGON

SCALE 4" = 1 MILE



6-24-75

T-3275