


T.37S.R.4W.W.M.

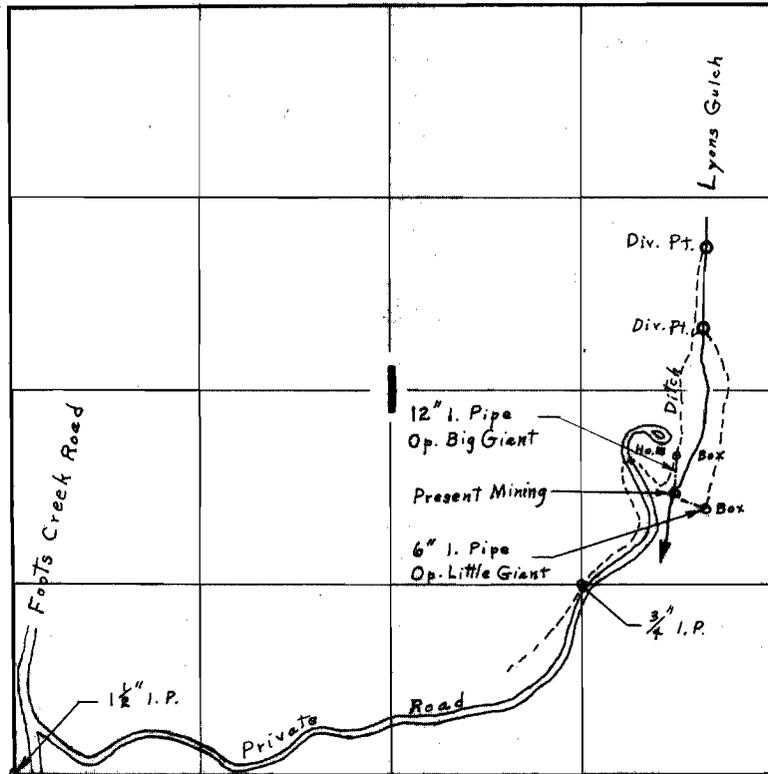

N. Div. Pt. Located 870' E, & 2300' N.

S. Div. Pt. Located 850' E, & 1750' N.

Both From S.W. Cor. N.E. $\frac{1}{4}$, S.E. $\frac{1}{4}$ Sec. 1

FINAL PROOF SURVEY UNDER

Application No. 34391. Permit No. 27020.
IN NAME OF

Gilbert D. Hice

Surveyed June 4, 1966, by L. E. Gould