


T. 36 S., R. 2 W., W.M.

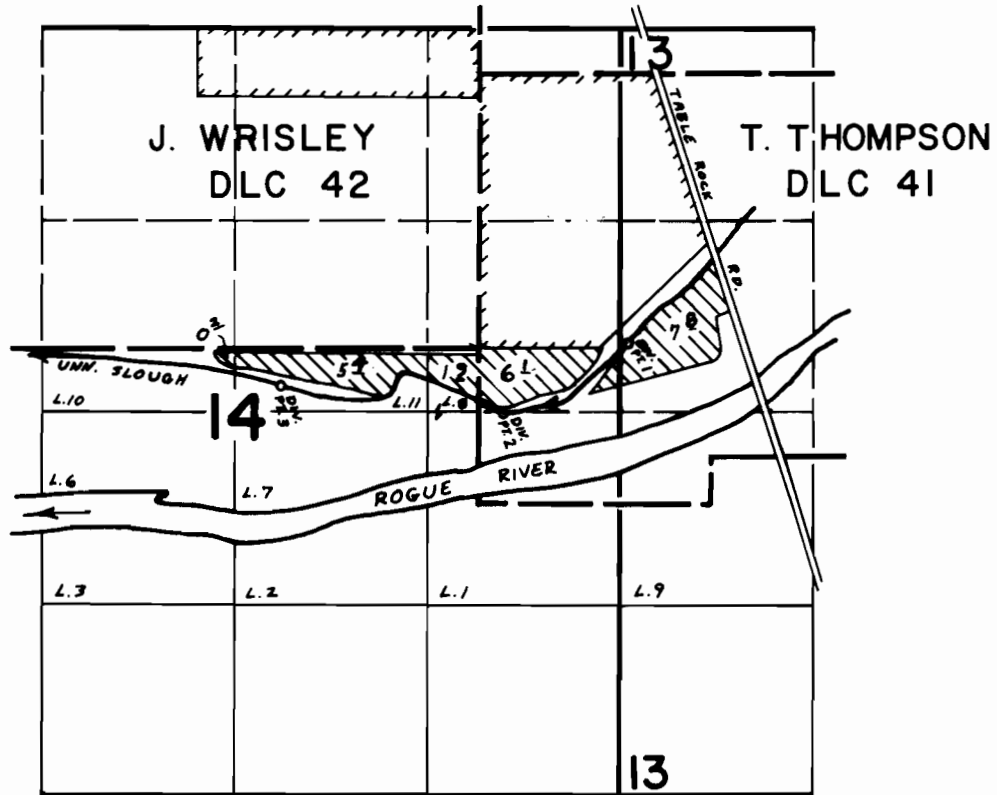

DIV. PT. 1: 460' N of 50' E from the E 1/4 cor. of SEC. 14.
 DIV. PT. 2: 770' W from the E 1/4 cor. of SEC. 14.
 DIV. PT. 3: 160' N of 300' E from the C 1/4 cor. of SEC. 14.

FINAL PROOF SURVEY UNDER

Application No. ~~4944~~ Permit No. 37040...
 IN NAME OF

.....MARY.....DARLING.....

Surveyed JULY 28, 1980, by B.R. SUND.....

Scale 4" = 1 mile